

Plotted

WELL LOG BUREAU \* KANSAS GEOLOGICAL SOCIETY  
UNION NATIONAL BANK BLDG, WICHITA, KANSAS


Plotted  
R.S.

Location SW corner SE

Sec. 27 T. 10 R. 25E.

County- Wyandotte JUN 30 1930

Casing Record		Farm- U. P.	No. 8
20"	10"	Company- Kansas City Industrial Land Co.	
15 1/2"	8 1/4"	Contr.-	
12 1/2"	65/8"	Comm.- 9/8/28.	Comp.- 9/12/28.
	53/16"	Shot	Quarts Between

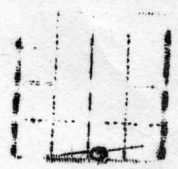

Total Depth 425'.  
Correspondence Regarding This Well Should Be Referred to

Elevation East 743

Figures Indicate Bottom of Formations.  
Date Issued: 6/28/1930.

Initial Production Dry.

Formation	Depth
soil	10
sand	70
gravel	117
shale	160
sd lime	172
shale	175
gr shale	181
red rock	185
gray sand	190
oil sand show oil	200
sand gray	210
sd lime	215
lime	220
lime	230
shale	235
sand show oil	242
shale	245
shale	252
lime	258
shale	263
sd lime show oil & gas	270
shale	283
lime	287
shale Show gas & water	290
shale lime	300
lime	305
shale	312
lime	322
shale	328
sand lime	343
shale	387
sand Puff gas	402
brown shale	420
shells	425
Total Depth	425'

Source

31'

Set

Log From Gas Well, The Kansas City Industrial Land Company,  
Fairfax Industrial District, Kansas City, Kansas.

TOR  
27-10-25  
1990 F E Lino  
200 " S "

Well No. 8.


<u>Thickness of strata</u>	<u>Name of rock</u>	<u>Total depth</u>	
10'	Sandy soil	00' to 10'	
60'	Fine sand	10' " 70'	
67'	Coarse sand & gravel	70' " 117'	Set 8" casing at 117'
43'	Blue shale	117' " 160'	
12'	Gray sandy lime	160' " 172'	
3'	Gray shale	172' " 175'	
6'	Green shale	175' " 181'	
4'	Red shale	181' " 185'	
5'	Gray sand	185' " 190'	
10'	Oil sand	190' " 200'	Showing of oil.
10'	Fine gray sand	200' " 210'	
5'	Sand and lime	210' " 215'	
5'	Gray lime	215' " 220'	
10'	Brown lime	220' " 230'	
5'	Light gray shale	230' " 235'	
7'	Gray sand	235' " 242'	Showing little oil
3'	Light gray shale	242' " 245'	
7'	Blue shale	245' " 252'	
6'	Brown lime	252' " 258'	
5'	Light shale	258' " 263'	
7'	Sandy lime	263' " 270'	Showing gas and oil
13'	Dark shale	270' " 283'	
4'	Black lime	283' " 287'	
3'	Black shale and slate	287' " 290'	Salt water and gas
10'	Slate and lime	290' " 300'	
5'	Gray lime	300' " 305'	
7'	Gray shale	305' " 312'	
10'	Gray lime	312' " 322'	
3'	Black shale	322' " 325'	
3'	Light shale	325' " 328'	
15'	Gray sandy lime	328' " 343'	
7'	Light shale	343' " 350'	Set 6 1/2" casing at 345'
10'	Blue shale	350' " 360'	
5'	Black shale	360' " 365'	
22'	Blue shale	365' " 387'	
15'	Gray sand	387' " 402'	Fuff of gas
13'	Brown shale	402' " 420'	
5'	Limey gray shale	420' " 425'	

Location:

Fairfax  
Between Lots 26 & 27- 125' East of Rickel Road.  
Elevation top of ground at well 329.5

413.5  
743.0  
329.5  
460

Company \_\_\_\_\_  
Farm \_\_\_\_\_  
27 To 10 R 25 E  
Tp No. \_\_\_\_\_ Well No. 8

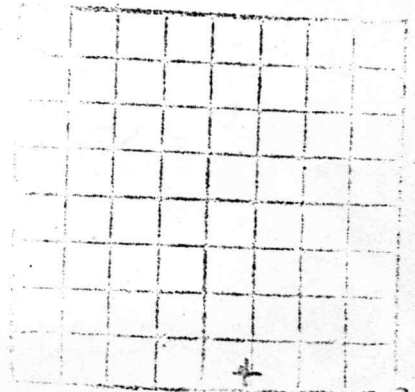

558-