


Section 12 Township 18 Range 7 W

Well No. #3 Kottman

Company E. H. Riggs

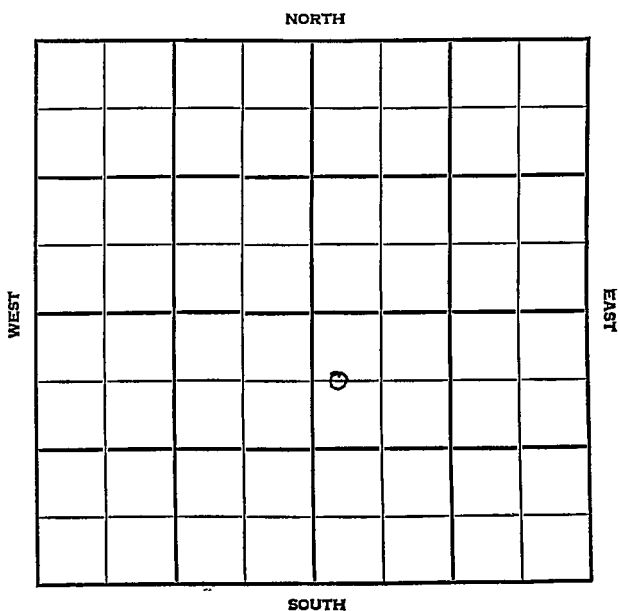


12 18 7 W

WELL NO. # 3 Kottman FARM

COMPANY E. H. Riggs

CONTRACTOR Prime Crawford

_____ Ft. from N. Line
 _____ Ft. from S. Line
 _____ Ft. from E. Line
 _____ Ft. from W. Line

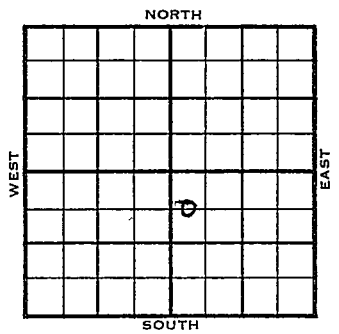

C W $\frac{1}{2}$ NW SE
 SDX Lease 1/8 Mile
 SDX - FO

	ELEVATION	REPORT
1955	1696 RB	

9/14 Comm. 9-9-55
 8" @ 201/150
 Drlg. 1557'

9-22 Tops: Heeb. 2582 Tor. 2601
 Doug. 2628 Br.Ls 2699
 Lsg. 2734 Congl. Sd 3190
 RTD 3191'
 5 $\frac{1}{2}$ " @ 3191'

9-29 DP DD 3193 in sand, no show;
 Shale from 3193 to 3228 TD

10/5 Comm 9-9-55
 8" @ 201/150
 Anh 970
 H 2582
 Tr 2601
 Dg 2628
 Bl 2699
 L 2734
 C 3190
 TD 3191

DD 3227
 D & A

ABANDONED

County Rice Elev. _____
 Sec. 12 Twp. 18 Rge. 7W
 Company E. H. Higgs
 FarmName Kottman No. 3

TOPS	DEPTH	LOG	DATUM	Loc. in Sec.
Anh.	<u>970</u>			<u>C W 1/4 NW SE</u>
Tp.				
H.				
Tr.				
Dg.				
Bl.				
L.				Geol. _____
K.C.				Contr. _____
B.K.C.				<u>Prime</u>
Ce.				
C.				Pool _____
M.				<u>Crawford</u>
M.				
K.				
Mz.				
Me.				
V.				
S.				
S.			<u>SDXISE</u>	<u>1/8 mile</u>
A.				
R.				
PE.				FIRST REPORT
G.				<u>070</u>
T.D.				<u>SEP 1 1955</u>

Date Comm. 9-9-55
8" @ 201/150 drlg. 1557

Co.
 Sec.
 No.
 Sec.
 T.
 R.

County Rice Elev. 1676 RB
 Sec. 12 Twp. 18 Rgs. 7W
 Company E. R. Riggs
 FarmName Kottman No. 3

TOPS	DEPTH	LOG	DATUM	Loc. in Sec.
Anh.	970			C W $\frac{1}{2}$ NW SE
TP.				
H.	2582		886	
Tr.	2601		905	
Dg.	2628		932	
Bl.	2699		1003	
L.	2734		1038	
K.C.				Geol.
B.K.C.				Contr.
Ce.				
C.	3190		1494	Prime
M.				Pool
M.				
K.				Crawford
Mz.				
Me.				
V.				
S.				
S.				
A.				
R.				
PE.				
G.				
TD.	3191			

Date Comm. 9-9-55 OCT 5 1955

8" @ 201/150 TD. 3191 DD 3227

D & A

ABANDONED