


Section 12 Township 18 Range 7W

Well No. #1 Little

Company E.H. Riggs

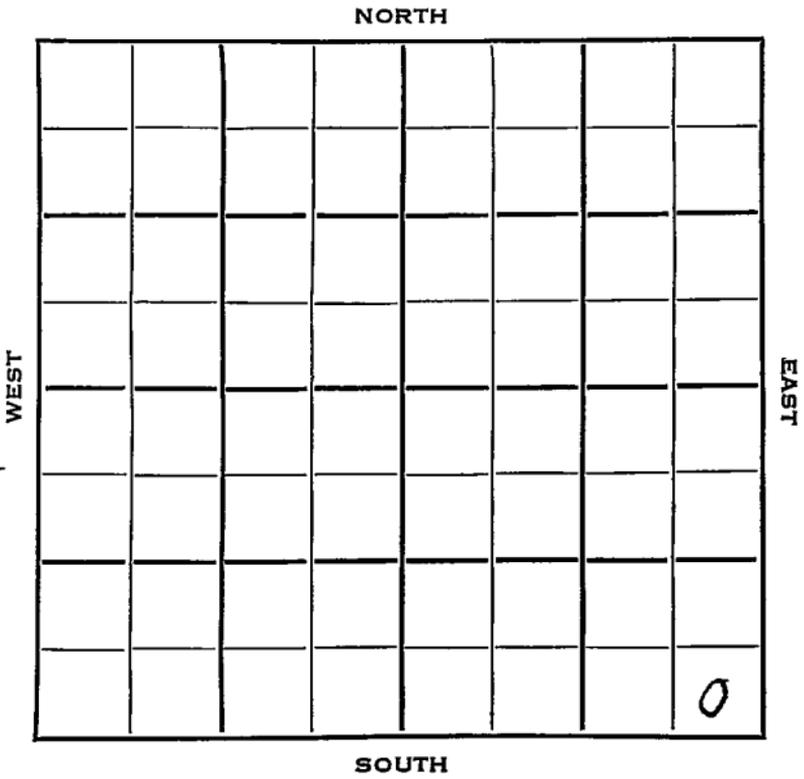

HOT FILE Rice KANSAS


SEC. 12 TWP. 18 R. 7 W ✓

WELL NO. # 1 Little FARM COMPANY

CONTRACTOR E. H. Riggs

Prime Drlg. Wildcat

_____ Ft. from N. Line
 330 _____ Ft. from S. Line
 330 _____ Ft. from E. Line
 _____ Ft. from W. Line

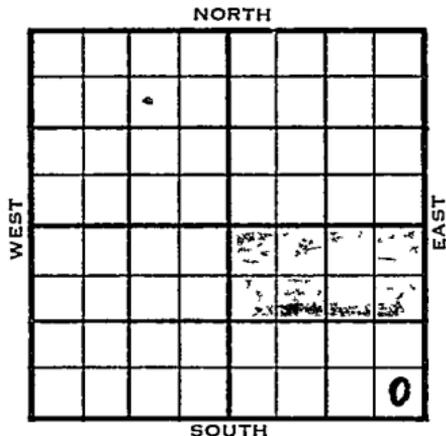

SE SE SE
 Sun Farmout

	ELEVATION	REPORT
1953	1698'	

10/7 RUR
 10/15 Spud 10-7-53 8-5/8" @ 214
 Anhy 1044' Heabner 2591'
 Br Li 2708' Lans 2745'
 Sand (Misner or Conglo ?) 3193',
 spotted stain w/show free oil.
 DST 3195-99', 1 hr, 3140' gas in
 pipe, 480' gassy oil, 5 gals watery
 mud, w/slight salty taste.
 BHP 800# K H 3211' V 3384'
 Drlg. ahead. Drlg. 3290 (Tel-McGehee)
 10/22 Simp. 3480' Arb. 3538'
 TD 3587' 5" @ 3275 elec log. (Ltr-McG
 10/29 Perf 24/3194-98, 18/3199-3201
 FU 1000' oil in 4 hrs, S/2 1/2 BOPH
 for 20 hr. 200 mud-acid. S/3 1/2 BOPH
 for 4 hrs. POP (Ltr-McGehee)
 11/5 P/61 BO 1st day & 60 BO 2nd day. "
 11/11 NR
 11/19 Completed for 50 BOPD (Ltr-McGehee)

2745
 1698
 1047

OVER

1953

11/18

Spud 10-7-53

Oil Well

TD 3587'

8" @ 214'

Anhy 1044', Heeb 2591', Br lime

2708', Mans 2745', Cong 3193'

DST 3195-99', opn 1 hr.,

FU 3140' gas, in pipe, 480' gassy oil,

5 gal. wtry mud, 800#

Kh 3211', Viola 3384', Simp 3480',

Arb. 3538'

TD 3587'

5" @ 3275'

24/3194-98, 18/3199-3201

FU 1000' oil, 4 hrs.

S/2 $\frac{1}{4}$ boph 20 hrs., 200 mud-a~~cted~~

S/3-1/3 boph 4 hrs.

P/61 bo 1 day

P/60 bo 2nd day


Comp. 50 bopd

COMPLETED

3574

1655

1879

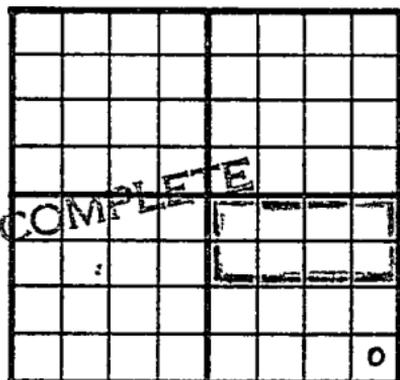County Rice State KansasSec. 12 (Blk.
Twp.) 18 (Sur.
Rge.) 7W Map No.Operator E. H. RiggsWell No. 1 Farm LittleElev. 1698 Location SE SE SE330 Ft. From S Line SE330 Ft. From E Line Quarter

1st. Report

Completion NOV 18 1953Remarks WildcatPrime Drlg. - Contr.Spudding Date 10-7-53Drlg. Data Oil well TD 35878" @ 214 Anhy 1044 Heep. 2591Br. lime 2708 Lans. 2745 Cong. 3193DST 3195-99 open 1 hr. ~~FE~~ 3140' gasin pipe 480' gassy oil 5 gal. wtry mud800# Kh. 3211 Viola 3384 Simp. 3480Arb. 3538 TD 3587 5" @ 327524/ 3194-98 18/ 3199-3201 FU 1000' oil4 hr. S/ 2 1/4 boph 20 hr. 200 mud-acidS/ 3 1/3 boph 4 hr. P/ 61 bo 1 dayP/ 60 bo 2nd day Comp. 50 bopd

J. G. McGEHEE