

Map No. 71 Sec. 25 Twp. 29 R. 5
Well No. 6 Brown Farm
Leavis del Company

N

A

三

S

Location -----

Drilling Remarks:

Rig Up

Drilling Remarks:

RECORD

Cased ----- in.-----ft.

Sand -----

Gas -----

Oil _____

Total Depth_____

PRODUCTION

1st 24 hrs. Nat.-----

1st 24 hrs. after shot-----

Gas ----- cu. ft.

Dry Hole -----

Abandoned -----

Map No. 1 Sec. 23 Twp. 24 R. 2

Well No. 20 Brown Farm

Lewis Oil Company


NORTH

Ft. from N. Line

200 Ft. from S. Line

700 Ft. from E. Line

Ft. from W. Line

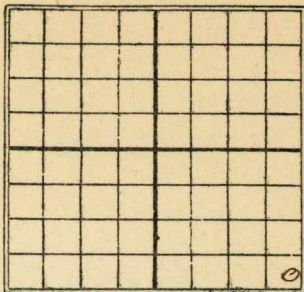

EAST

SOUTH

Date _____

REPORT

1922

1/27

2/4

3/30

Rig

Run up

Land 2709-2744 Shot
10 qts 192 bbls 1st
24 hrs. T.D. 2744

10 qts 192 bbls 1st

24 hrs. T.D. 2744

Map No. K 11 Sec. 25 Twp. 29 R. 3Well No. 6 BrownLewis Oil Company

Contractor

FIRST REPORT**SECTION PLAT**

Ft. from N. Line

200 Ft. from S. Line200 Ft. from E. Line

Ft. from W. Line

Location

Rig up

Drilling and Remarks:

Rig.**RECORD**

Cased _____ in., _____ ft.

Sand _____

Gas _____

Oil _____

Total Depth _____

PRODUCTION

1st 24 hrs. Nat. _____

1st 24 hrs. after shot _____

Gas _____ Cu. Ft.

Dry Hole _____

Abandoned _____

Date

JAN 27 1922

191

M. A. BENEAR

Scout

Kansas

Map No. *K11* Sec. *35* Twp. *29* R. *5*

Well No. *6 Brown*

Lewis Oil Company

Contractor

COMPLETED

SECTION PLAT

----- Ft. from N. Line

200 Ft. from S. Line

200 Ft. from E. Line

----- Ft. from W. Line

Location -----

Rig up -----

Drilling and Remarks:

sand 2709-44
shot 10 lb
192 lb 1st
24 hr after
shot

RECORD

Cased ----- in., ----- ft.

Sand -----

Gas -----

Oil -----

Total Depth *2744*

PRODUCTION

1st 24 hrs. Nat. -----

1st 24 hrs. after shot -----

Gas ----- Cu. Ft.

Dry Hole -----

Abandoned -----

Date

MAR 30 1922 191

M. A. BENEAR

Scout