


DX 78-1

Rice KANSAS

Section 12 Township 18 Range 7W

Well No. 4 Little

Company Riggs & Prime

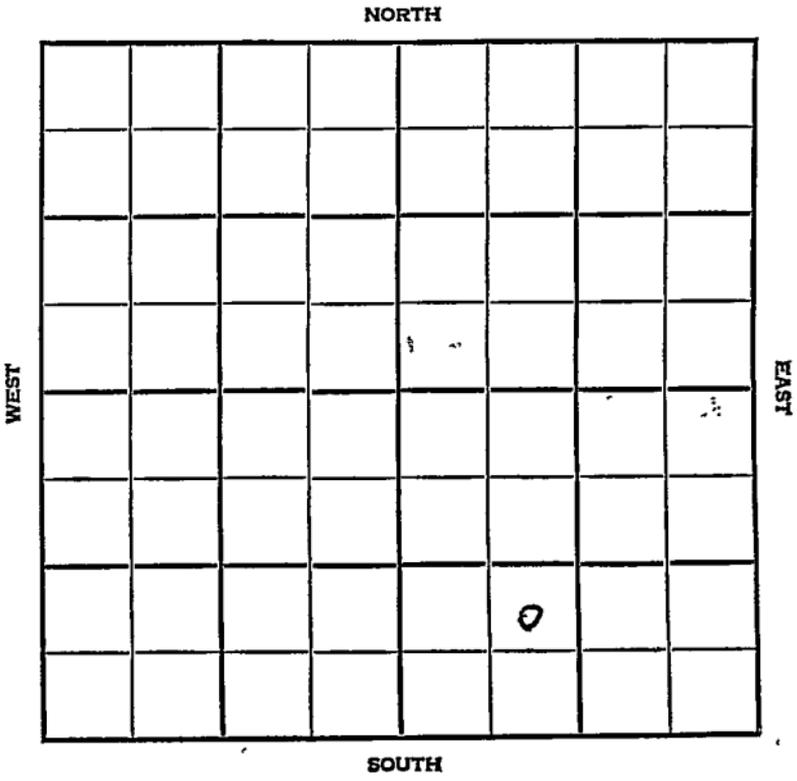

HOT FILE

Rice

KANSAS

SEC.	TWP.	R.
12	18	7 W

WELL NO. # 4 Little FARM

COMPANY Riggs & Prime

CONTRACTOR Prime

Geneseo Pool

_____ Ft. from N. Line


990 _____ Ft. from S. Line

_____ Ft. from E. Line

990 _____ Ft. from W. Line

NE SW SE

OFFSET

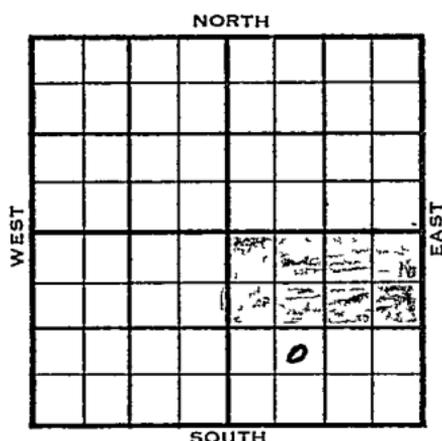

	ELEVATION	REPORT
1955	1686'	
3/2	Spud 2-22-55 8" @ 207 Drlg. 2810'	
3/10	Heeb 2575' Tor 2602' Doug 2625' Br. lime 2691' Lans 2727', 1st Cong. 3176', 2nd Cong. 3188' TD 3193' 4 $\frac{1}{2}$ " @ 3189 WOCT. (Ltr-Gilstrap)	
3/17	CO	(Ltr-Gilstrap)
3/24	12/3177-80 CO to 3193', frac S/3 $\frac{1}{2}$ boph - PB 3184, 16/3178-82 B/30 goph, frac, 2000A S/L, POP	"
3/30	No report.	"
4/14	P/ 18 bopd.	"
4/21	Completed for potential of 30 BOPD. (Ltr-Gilstrap)	
4/20	Spud 2-22-55 Oil Well TD 3193' 8" @ 207' Heeb 2575', Tor. 2602' Doug. 2625' Br. Lime. 2691', Lans. 2727' Cong. 3176'	

1955

Information brought forward.

4/20

TD 3193'

4 $\frac{1}{2}$ " @ 3189'

CO 12/ 3177-80 CO to 3193 frac.

S/ 3 $\frac{1}{2}$ boph PB 3184'

16/ 3178-82 B/ 30 goph frac.

2000 A P/ 18 bopd.

Comp 30 bopd.

COMPLETED


County Rice State Kansas

Sec. 12 (Blk. 18) (Sur. 7W) Map No. 18

Operator Riggs & Prime

Well No. 4 Farm Little

Elev. 1686 Location NE SW SE

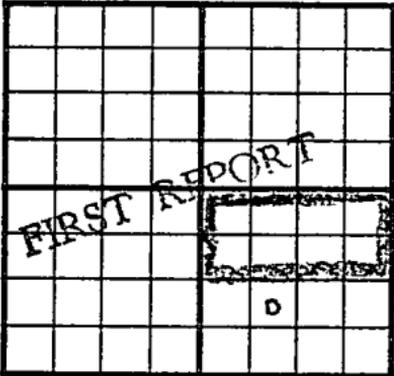

990 Ft. From S Line SE

990 Ft. From W Line Quarter

1st. Report MAR 2 1955

Completion

Remarks

Prime - Contr.

Spudding Date 2-22-55

Drlg. Data Geneseo Pool

8" @ 207 drlg. 2810

FABEN GILSTRAP

