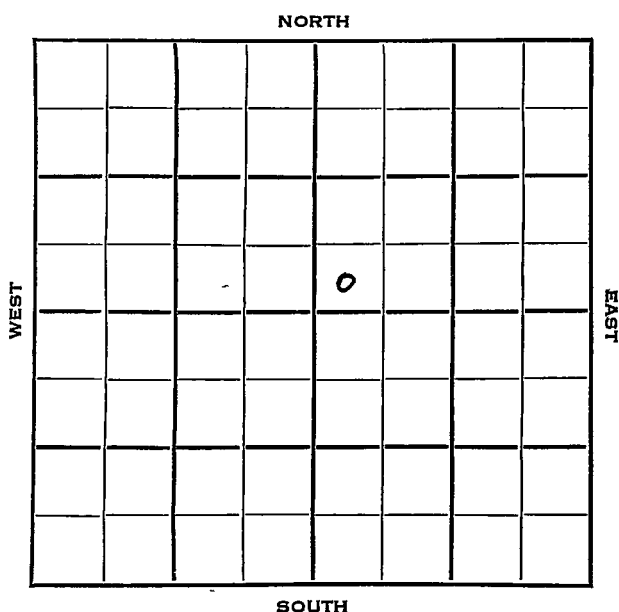


Section 12 Township 18 Range 7WWell No. 1 TaylorCompany E. H. Riggs

HOT FILE Rice **KANSAS**

SEC. 12 TWP. 18 S R. 7 W ✓

WELL NO. # 1 Taylor FARM

COMPANY

CONTRACTOR E. H. Riggs

Prime Drlg.


Ft. from N. Line

330 Ft. from S. Line

Ft. from E. Line

330 Ft. from W. Line

SW SW NE

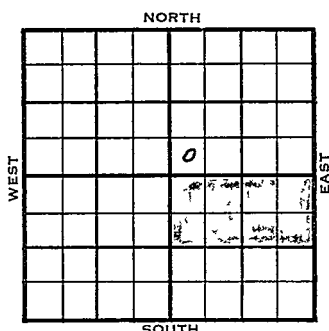

MCPC \$2500 DHM Sunray DHM Magnolia F/O

	ELEVATION	REPORT
1954	1698' RB 1693' Gr.	
		Arbuckle Lime approx 3550'
1/27		To commence not later than Mar. 1, 1954
		To complete not later than May 1, 1954
2/24		Cellar & Pits (F.R.)
2/25		Digging rotary pits. (Card-Riggs)
2/26		Moving in rotary tools "
2/28		Set surface pipe 8-5/8" @ 209
		w/125 sacks. "
3/2		Drlg. 1290' "
3/3		Drlg. 1790' "
3/4		Drlg. 2360' "
3/5		Drlg. 2630' "
3/6		Drlg. 2985' "
		Top Heebner 2604 Top Br Lime 2723'
		Top Lansing 2761 (Card-Riggs)
3/8		DST #1, 3036-3050' open 1 hr, weak
		blow 40 min, rec 8' mud, 2' oil,
		20 min BHP 55#.
		DST #2 3198-3231' open 1 hr, fair
		blow thruout, rec 120' SO & GCM,
		20" BHP 80# IFP 15# FFP 35#
		(Card-Riggs)
3/9		Drlg. 3402'
		Top Misener Sand 3349' "
3/10		Drlg. 3520' "

OVER

1954

3/11

Tops: Heebner 2604', Brown li 2724',
Lansing K.C. 2761', Congl. Sd 3222',
Misener 3347', Viola 3470',
Maquoketa 3414', Arbuckle 3574',
Simpson 3522'
Rotary TD 3613' D & A (Card-Riggs)

3/17

Spud 2-28-54

D & A

TD 3613'

8" @ 209'

Heeb 2604', Br. Lime 2723', Lans 2761',
DST 3036'-50' opn 1 hr, rec 8' wcm,
2' Mud 0#

DST 3198'-3231' opn 1 hr, rec 120'
so & gcm 80# Meisner 3349'

Cong 3218', Maq 3414', Viola 3466'
Arb 3577'

TD 3613'


Schlumberger Tops: Heeb 2604',
Br. Lime 2724', KC 2761', Cong 3222'
Meisner 3347', Maq 3414', Viola 3470'
Simp 3522', Arb 3574'

D & A

ABANDONED

J. G. McGEHEE

County Rice State Kansas
 Sec. 12 (Blk. 18) (Sur. 7W) (Twp.) Map No.
 Operator E. H. Riggs
 Well No. 1 Farm Taylor
 Elev. 1695 Location SW SW NE

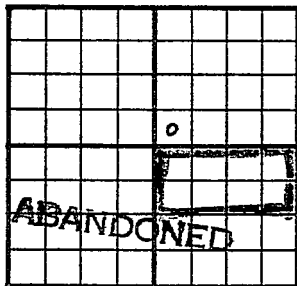

330 Ft. From S Line NE
330 Ft. From W Line Quarter
 1st. Report
 Completion MAR 17 1954
 Remarks Wildcat
Prime Drlg. - Contr.
 Spudding Date 2-28-54

Drlg. Data D & A TD 3613
8" @ 209 Heeb. 2604 Br. lime 2723
Lans. 276.1 DST 3036-50 open 1 hr.
Rec. 8' wcm 2" mud 0# DST 3198-3231
open 1 hr. Rec. 120' so & gcm 80#
Meisner 3349 Cong. 3218 Maq. 3414
Viola 3466 Arb. 3577 TD 3613
SCHLUMBERGER TOPS
Heeb. 2604 Br. lime 2724 KC 2761
Cong. 3232 Meisner 3347 Maq. 3414
Viola 3470 Simp. 3522 Arb. 3574

D & A

J. G. McGEHEE