

Section 13 Township 18 Range 7WWell No. #2 ~~#1~~ BronleeweCompany E.H. Riggs

|  |  |  |  |  |  |  |   |
|--|--|--|--|--|--|--|---|
|  |  |  |  |  |  |  | 0 |
|  |  |  |  |  |  |  |   |
|  |  |  |  |  |  |  |   |
NORTH

WEST

EAST

SOUTH

## HOT FILE

KANSAS

SEC. 13 TWP. Rice R. 7 W ✓

WELL NO.

# 2 Bronleewe

FARM

COMPANY

E. H. Riggs

CONTRACTOR

Prime Drlg.  
Crawford Pool

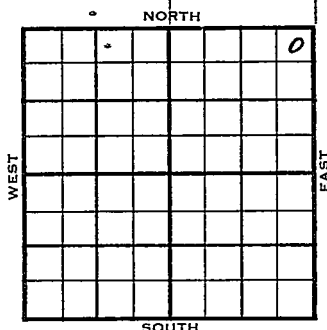
330 Ft. from N. Line

Ft. from S. Line

330 Ft. from E. Line

Ft. from W. Line

NE NE NE

MCPC has N $\frac{1}{2}$  SE of 12

|      | ELEVATION   | REPORT          |
|------|---|-----------------|
| 1954 | 1694'   |                 |
| 3/10 | Location   |                 |
| 3/17 | 8" @ 209' w/125 sks<br>Drlg. 1760'   |                 |
| 3/24 | Heeb 2578', Tor 2598', Br li 2693',<br>Lans 2728', Cong 3178'<br>C 3176-3209<br>Drlg. 3233'                                                                |                 |
| 3/31 | RTD 3270 5" @ 3270 Perf ?<br>S/2 $\frac{1}{2}$ BOPH FU 1000' oil 12 hrs.<br>400 MA FU 2200' fluid 50% wtr.                                                 |                 |
| 4/7  | PB 3208'<br>Hyd<br>S/4 $\frac{1}{2}$ boph 8 hrs., POP   |                 |
| 4/14 | POP   |                 |
| 4/28 | Spud 3-12-54<br>Oil Well<br>TD 3270'<br>8" @ 209'<br>Anhy 1015', Heeb 2578', Tor 2598'<br>Br. Lime 2693', Lans 2728', Cong 3178'<br>TD 3270'<br>5" @ 3270' |                 |
|      | Perf 3223-32   | 3211-17 3204-06 |

1954

Information brought forward.

4/28

3199'-3201' 3189'-95' S/  $2\frac{1}{2}$  boph  
FU 1000~~8~~ oil 12 hr.

400 mud-acid FU 2200' fluid 50%  
Wtr.

PB 3208'

Hydro. S/  $4\frac{1}{2}$  boph

8 hr. CO to 3248 18/ 3221-24

12/ 3210'-12 23/ 3194'-98' B/  $2\frac{1}{2}$   
boph 24/ 3194'-3202' 250 gal mud  
acid, FU 2100' wtr.

SP 3205

S/  $1\frac{1}{2}$  boph 8 hr. S/ 4 boph

P/ 72 bopd

Comp 198 bopd.

**COMPLETED**

J. G. McGEHEE

Kansas

Map No. \_\_\_\_\_ Sec. 13 Twp. 18 R. 7WWell No. 2 Bronleewe

E. H. Riggs

Company

**CORRECTION**

Contractor

NE NE NE

SECTION PLAT.

330 Ft. from N. Line

\_\_\_\_\_ Ft. from S. Line

330 Ft. from E. Line

\_\_\_\_\_ Ft. from W. Line

|  |  |  |   |
|--|--|--|---|
|  |  |  | o |
|  |  |  |   |
|  |  |  |   |
|  |  |  |   |
|  |  |  |   |

Rice County

Location \_\_\_\_\_

Rig up \_\_\_\_\_

Drilling and Remarks:

Reported  
#1 Bronleewe

## RECORD

Cased \_\_\_\_\_ in., \_\_\_\_\_ ft.

Sand \_\_\_\_\_

Gas \_\_\_\_\_

Oil \_\_\_\_\_

Total Depth \_\_\_\_\_

## PRODUCTION

1st 24 hrs. Nat. \_\_\_\_\_

1st 24 hrs. after shot \_\_\_\_\_

Gas \_\_\_\_\_ Cu. Ft.

Dry Hole \_\_\_\_\_

Abandoned \_\_\_\_\_

Date

APR 14 1954

in

J. G. McGEHEE

Scout

County Rice State Kansas  
 Sec. 13 (Blk. 18 (Sur. 7W Map No.     )  
 (Twp.) (Rge.)  
 Operator E. H. Riggs  
 Well No. 2 Farm Bronleewe  
 Elev. 1694 Location NE NE NE

|  |  |  |  |  |  |   |
|--|--|--|--|--|--|---|
|  |  |  |  |  |  | 0 |
|  |  |  |  |  |  |   |
|  |  |  |  |  |  |   |
330 Ft. From N Line NE

330 Ft. From E Line Quarter

1st. Report

Completion APR 28 1954Remarks Crawford PoolPrime Drlg. - Contr.Spudding Date 3-12-54Drlg. Data Oil well TD 32708" @ 209 Anhy 1015 Heeb. 2578Tor. 2598 Br. lime 2693 Lans. 2728Cong. 3178 TD 3270 5" @ 3270perf/ 3223-32 3211-17 3204-063199-3201 3189-95 S/ 2 $\frac{1}{2}$  boph FU 1000'oil 12 hr. 400 mud-acid FU 2200' fluid50% wtr. PB 3208 Hydro. S/ 4 $\frac{1}{2}$  boph8 hr. 60 to 3248 18/ 3221-24 12/ 3210-12 23/ 3194-98 B/ 2 $\frac{1}{2}$  boph 24/ 3194-3202 250 gal. mud-acid FU 2100' wtr.SP 3205 S/ 1 $\frac{1}{2}$  boph 8 hr. S/ 4 bophP/ 72 boph Comp. 198 boph

J. G. McGEHEE