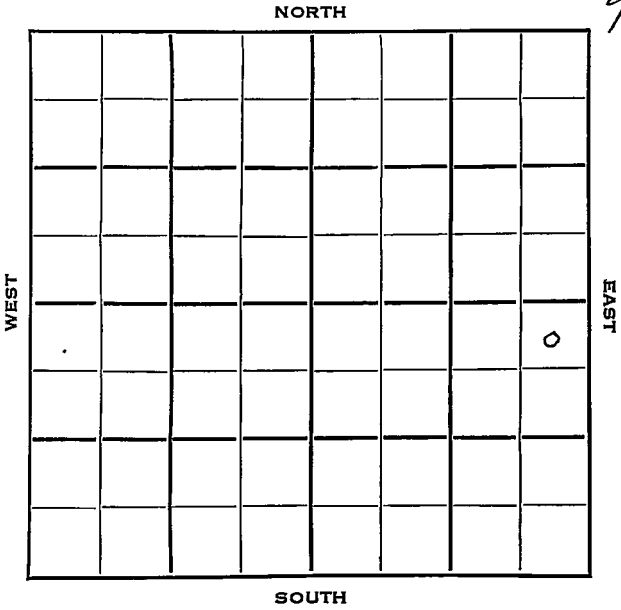


Cowley

KANSAS

FORM 51


Section 14 Township 34 Range 3EWell No. 2 SandersCompany Aylward Drlg.

Cowley **KANSAS**Sec. 14 Twp. 34 R. 3EWell No. #2 Sanders FarmAylward Drlg. CompanyAylward Drlg. Contractor

Harvey Pool

330 Ft. from N. Line Ft. from S. Line330 Ft. from E. Line Ft. from W. Line

NE NE SE

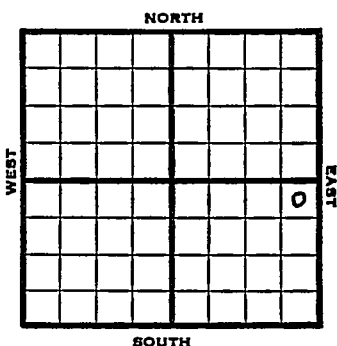

1953 Elev. 1132' REPORT

4/1 Spud 3-27-53
8" @ 92'
Drlg. 1987'

5/6 Spud 3-27-53
Oil Well
TD 3385'
8" @ 92'
Layton 2607, KC 2800, Miss 3359,
TD 3365
5" @ 3359'
DD 3385
PB 2822 24/ 2790-98 sd-frac
S/ 90 bo 3½ hr.
Comp. 69 bopd 50% wtr.

COMPLETED

J. G. McGEHEE

J. G. McGEHEE