


Section 25 Township 29 Range 5E

Well No. 1 Warner

Company Laura Jane Oil

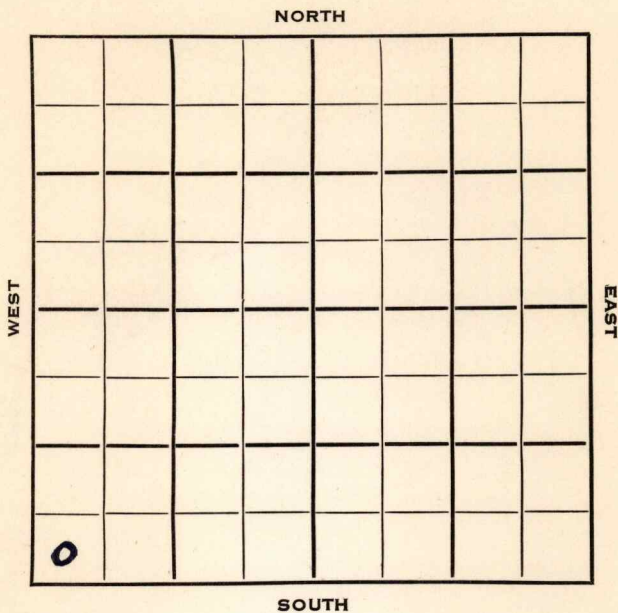

Sec. 25 Twp. 29 R. 5 E

Weil No. # 1 Warner Farm

Laura Jane Oil Company

Laura Jane Contractor


Ft. from N. Line

330 Ft. from S. Line

Ft. from E. Line

330 Ft. from W. Line

SW SW SW

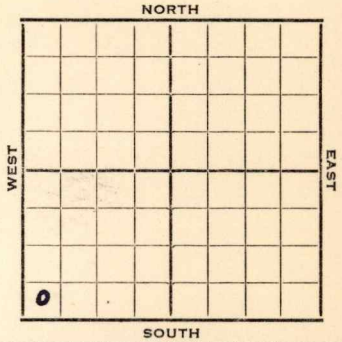

1952 Elev. 1284' REPORT

11/26 MIM

12/17 Spud 11-30-52  
 D&A  
 TD 2816  
 8" @ 120  
 KC 2133  
 cored 2730-47, rec. 17" shale  
 Bart 2718, Miss 2803  
 TD 2816  
 D&A

**ABANDONED**



