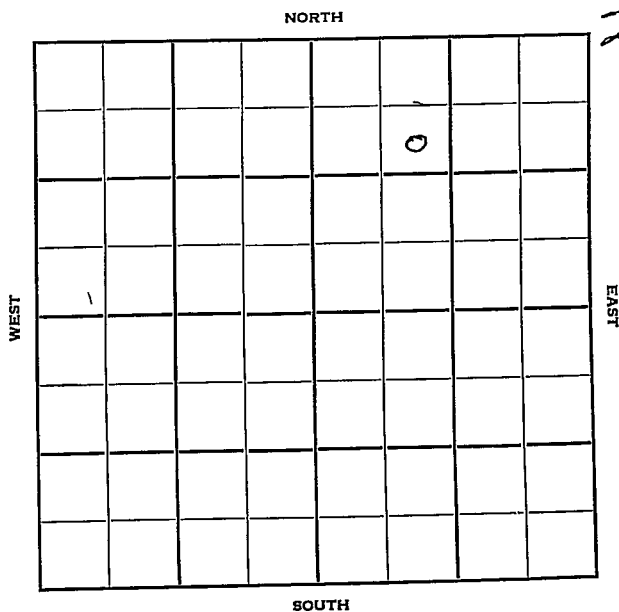


Section 15 Township 34 Range 3EWell No. #1 FunkCompany L. C. Smitherman

Cowley

KANSAS

Sec. 15 Twp. 34 R. 3E

Well No. #1 Funk Farm

L. C. Smitherman Company

Gross Drlg.  
E. Baird Pool Contractor


990 Ft. from N. Line

Ft. from S. Line

Ft. from E. Line

990 Ft. from W. Line

NE  $\frac{1}{4}$  SE NW NE

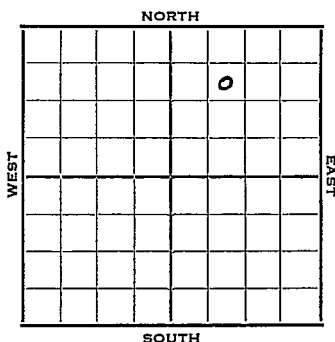


1952 Elev. 1157' REPORT

10/29 Spud 10-24-52  
8" @ 103'  
Drlg. 1231'

12/17 Spud 10-24-52  
Oil Well  
TD 3339  
8" @ 103  
Layton 2631, KC 2775, Bart  
3317  
DST 2650-82, opn 20 mins., rec.  
1  $\frac{1}{2}$  mcfg 360' mud 180' gcm  
30' socm 150' wtr 960#  
TD-3340  
5" @ 3325 lost hole  
Skid rig 60' south  
8" @ 102  
TD 3339 GO to 3339 Hydro.  
Comp. BHB 707 bopd

**COMPLETED**

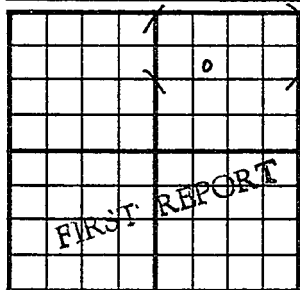County Cowley State KansasSec. 15 (Blk. Twp.) 34 (Sur. Rge.) 3E Map No.Operator L. C. SmithermanWell No. 1 Farm FunkElev. Location SE NW NE990 Ft. From N Line NE990 Ft. From W Line Quarter1st. Report OCT 29 1952

Completion

Remarks


Gross Drlg. - Contr.Spudding Date 10-24-52Drlg. Data E. Baird Pool8" @ 103 drlg. 1231

County Cowley State Kansas  
 Sec. 15 (Blk. 34) (Sur. 3E) Map No.

Operator L. C. Smitherman

Well No. 1-A Farm Funk

Elev. 1157 Location SE NW NE

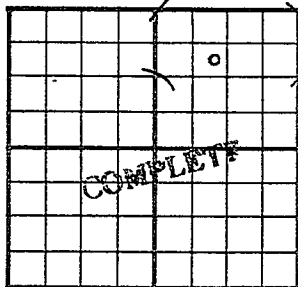

990 Ft. From N Line NE

990 Ft. From W Line Quarter

1st. Report

Completion DEC 17 1957

Remarks E. Baird Pool

Gross Drlg. - Contr.

Spudding Date 10-24-52

Drlg. Data Oil well TD 3339

8" @ 103 Layton 2631 KC 2775

Bart. 3317 DST 2650-82 open 20 min.

Rec.  $1\frac{1}{2}$  mcfg 360' mud 180' gcm

30' socm 150' wtr. 960# TD 3340

5" @ 3325 lost hole Skid rig 60' south

8" @ 102 TD 3339 CO to 3339 Hydro.

Comp. BHB 707 bopd

J. G. McGEHEE