


Section 14 Township 34 Range 3E

Well No. #2 Pearson

Company Crest Pet.

8

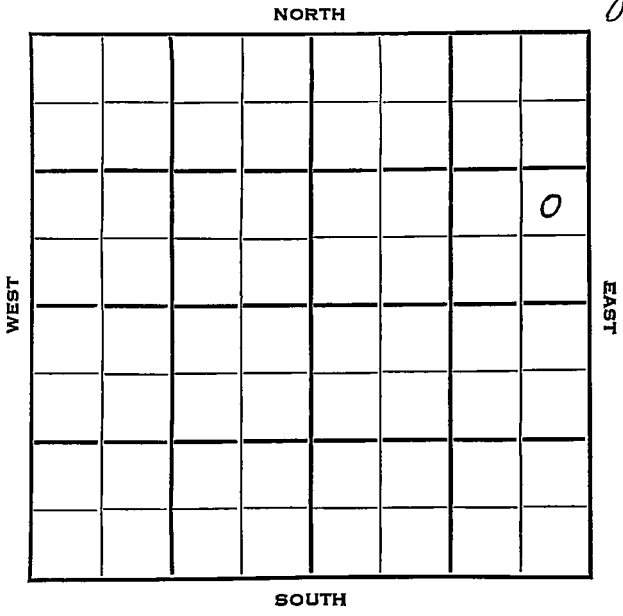

Cowley

KANSAS
3E

Sec. 14 Twp. 34 R. 3E

Well No. #2 Pearson Farm

Crest Pet. Company

Harvey Pool Contractor


Ft. from N. Line

910 Ft. from S. Line

330 Ft. from E. Line

Ft. from W. Line

NE SE NE (Twin Well)

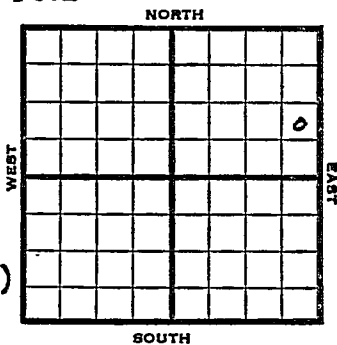

1953 Elev. 1133' REPORT

7/29 Spud 7-25-53
8" @ 80'
Drlg 1785'

9/2 Spud 7-25-53
Oil Well
TD 2870'
8" @ 80'
Layton 2632, KC 2821
TD 2870'
5" @ 2869'
30/ 2818-28 Hydro.
Comp. 67 bopd 20% wt.

COMPLETED

