


Section 14 Township 34 Range 3 E

Well No. # 2-W Pearson

Company Grest Pet.

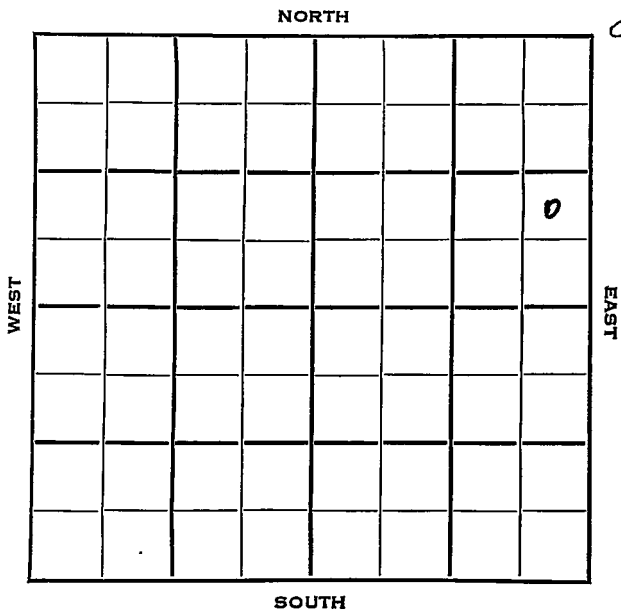

Sec. 14 Twp. - 34 R. 3E

Well No. #2-W Pearson Farm

Crest Pet. Company

Crest Pet. Contractor

Harvey Pool


_____ Ft. from N. Line

990 Ft. from S. Line

330 Ft. from E. Line

_____ Ft. from W. Line

NE SE NE

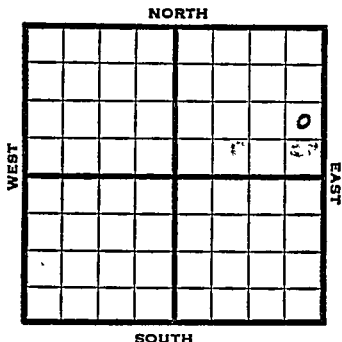

1953

Elev. 1133' REPORT

5/20

Spud 5-19-53
MIR

6/24

Spud 5-19-53
SWD Well
TD 4033
8" @ 86
Layton 2632, Bart 3354, Miss 3373,
Chat 3777, Simp 3840, Arb 3853
TD 4033
5" @ 3860
CO to 4033
Comp. for SWD Well

ABANDONED

