


Section 14 Township 34 Range 3E

Well No. 1 - Sanders

Company Aylward Drlg

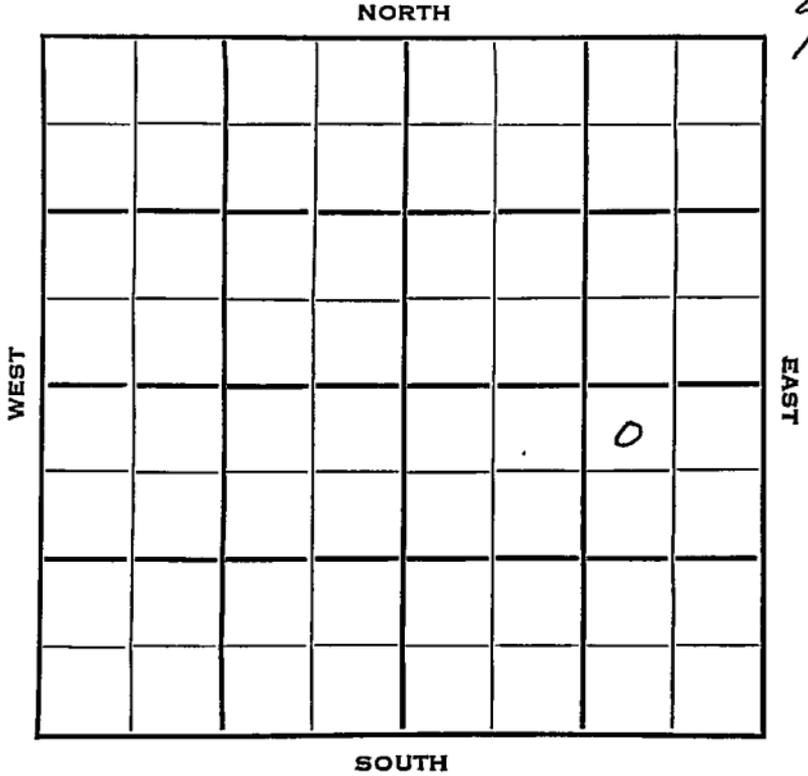

Sec. 14 Twp. 34 R. 3E

Well No. #1 Sanders Farm \_\_\_\_\_

Aylward Drlg. Company \_\_\_\_\_

Aylward Drlg. Contractor \_\_\_\_\_


330 Ft. from N. Line

\_\_\_\_\_ Ft. from S. Line

990 Ft. from E. Line

\_\_\_\_\_ Ft. from W. Line

NW NE SE

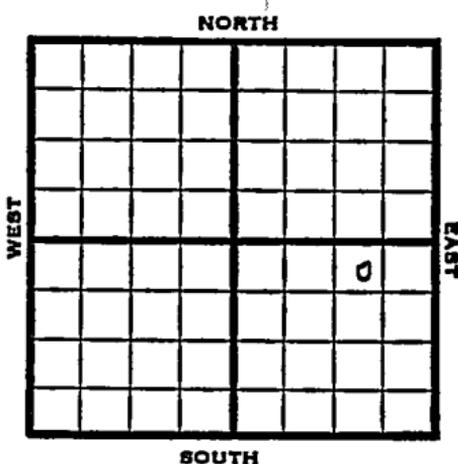

1953 Elev. 1142' REPORT

1/14  
2/25

Location  
Spnd 1-18-53  
Oil Well  
TD 3346  
8" @ 85  
Layton 2610, KC 2806, Miss  
3333  
TD 3343  
5" @ 3334  
DD 3346, S/25 bopd PB 2948  
Perf 2786-92, 16/2792-96  
FU 130' oil, 12 hrs., sd-frac  
F/100 boph F/25 boph  
Comp. 811 bopd

**COMPLETED**



