

WELL LOG BUREAU - KANSAS GEOLOGICAL SOCIETY  
UNION NATIONAL BANK BLDG WICHITA, KANSAS

Plotted  
R.S.


Location SWc NW $\frac{1}{4}$

Sec. 27T. 10R. 25E

County "yandotte.

Casing Record

20"	10"	Farm- U.P.	No. 21
15 $\frac{1}{2}$ "	8 $\frac{1}{2}$ "	Company- Kansas City Ind. Land Co.	
12 $\frac{1}{2}$ "	65/8"	Contr.-	
	53/16	Comm.- 7-6-29	Comp.- 7-20-29
Total Depth 385		Shot	Quarts Between

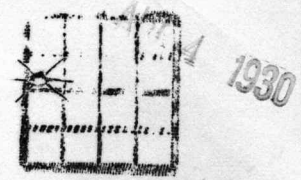

Correspondence Regarding This Well Should Be Referred to

Elevation 827.47

Figures Indicate Bottom of Formations.

Initial Production 377,000 G.

Date Issued. 8/2/1930

*Source  
26'  
sex*

Formation	Depth.
soil clay and river sand	55
coarse river sand	105
sdv shale	108
sdv shale	122
sand little water	135
shale light	140
shale blue	145
sdv shale light	185
shale dark	190
shale dark limey	200
shale light	205
lime brown	210
sdv shale light	228
shale dark gas	-232
lime brown	240
sand	245
shale dark	-258
lime blk	261
shale blk little gas	267
shale blue	279
lime grey	281
sand gas	283
limey shale	292
sdv lime	297
shale dark	304
sdv shale	324
shale dark	337
limsy shale dark	347
shale light	353
shale blk	356
shale grey	362
sand gas	378
sdv shale light	385
Total Depth.	
set packer	358
set cup packer	255

