

WELL LOG BUREAU - KANSAS GEOLOGICAL SOCIETY
UNION NATIONAL BANK BLDG, WICHITA, KANSAS

Plotted
RS.

Location NE SW SW NW.

Sec. 27 T. 10 R. 25E.

Casing Record
10"
20" 8 1/2"
15 1/2" 65/8"
12 3/4" 53/16"

Farm- U. P.

County- Wyandotte.

Company- Kansas City Industrial Land Co.

Contr.-

Comm.- 10/4/29

Comp.- 10/18/29.

Total Depth 400'

Shot

Quarts Between

Correspondence Regarding This Well Should Be Referred to

Elevation

827.40

Figures Indicate Bottom of Formations.

Initial Production

Dry.

Date Issued. 8/2/1930

Formation	Depth
soil	2
sand	18
fine river sand	55
coarse river sand	112
boulders & gravel	136
shale	143
sdv shale	165
shale	170
shale	190
shale & mud	196
shale	205
lime	210
limey shale	225
sdv shale	232
lime	240
shale little oil	245
shale	259
shale Gas	269
lime	275
sdv shale	280
red bed	285
shale Gas at 289'	300

Formation	Depth
sdv limey shale	312
sdv shale	335
shale	360
sdv shale	368
sand Gas	394
shale	400
Total Depth	400

Pauser

37'

37'

63 2/3

Log From Gas Well, The Kansas City Industrial Land Company
Fairfax Industrial District, Kansas City, Kansas.

Well No. 22.

27-10-25E
3000' FSL
300 " W "

Thickness of strata	Name of rock			
2'	Soil	0'	00'	02'
16'	Loose sand	02'	"	18'
37'	Fine river sand	13'	"	55'
57'	Coarse river sand	55'	"	112'
23'	Boulders & gravel	112'	"	135'
7'	Blue shale	135'	"	143'
22'	Sandy blue shale	143'	"	165'
5'	Blue shale	165'	"	170'
20'	Light blue shale	170'	"	170'
6'	Brown shale & mud	170'	"	196'
3'	Blue shale	196'	"	205'
5'	Gray lime	205'	"	210'
15'	Limey shale	210'	"	225'
7'	Sandy shale	225'	"	232'
8'	Brown lime	232'	"	240'
5'	Light shale	240'	"	245'
16'	Light blue shale	245'	"	259'
10'	Dark shale (gas)	259'	"	269'
6'	Gray lime	269'	"	275'
5'	Dark brown sandy shale	275'	"	280'
5'	Red bed	280'	"	285'
9'	Black shale	285'	"	294'
6'	Light gray shale	294'	"	300'
12'	Sand, limey shale	300'	"	312'
23'	Light sandy shale	312'	"	335'
5'	Dark gray shale	335'	"	340'
5'	Dark shale	340'	"	345'
10'	Gray shale	345'	"	355'
5'	Dark shale	355'	"	360'
8'	Dark sandy shale	360'	"	368'
26'	Sand & gas	368'	"	394'
6'	Light gray shale	394'	"	400'

water

Set 137'-9" 8" casing

Set 168'-4" 4-7/8" casing

Bubble of gas 228'

Little oil

gas 239'


746
269
477

Company

Form

No. 27 Tp. 10 S R 25 E

Map No. Well No. 22

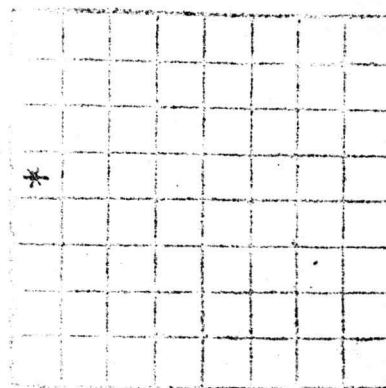

Elevation 332.04

DRY

413.5
745.5