

KANSAS


Form 51-5M-7-39-Palace

Rice

Section 18 Township 18 Range 7-W

Well No. #1 Carrie Durr

Company Herndon Drilling

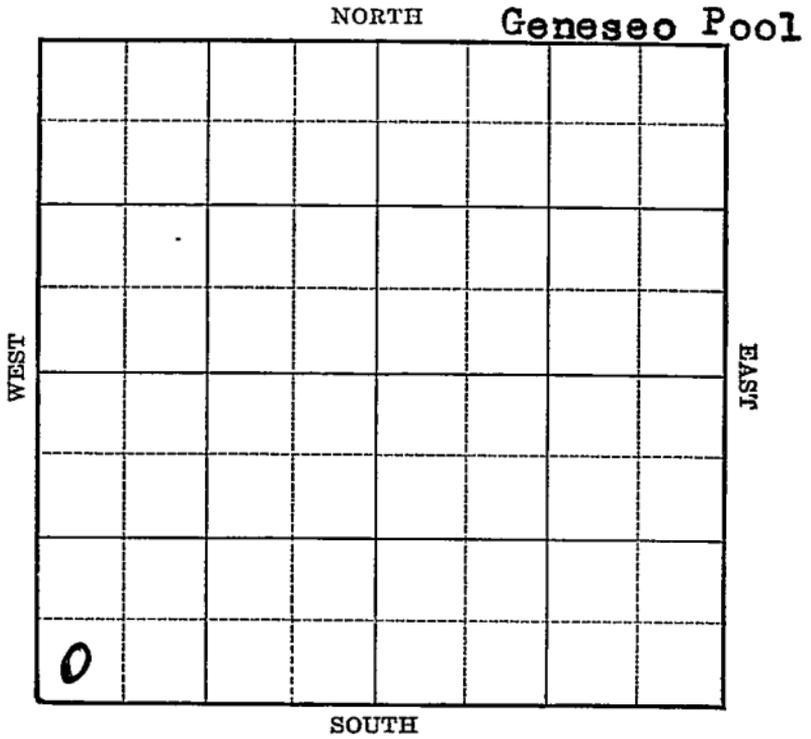

Rice

KANSAS

Map No. 45 Sec. 18 Twp. 18 R. 7WWell No. 1 Carrie DurrHerndon Drilling


Company

Contractor

ABANDONED

SW/C

SECTION PLAT

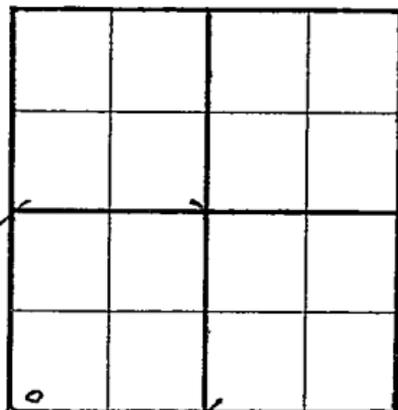

_____ Ft. from N. Line

330 Ft. from S. Line

_____ Ft. from E. Line

330 Ft. from W. Line

GENESEO POOL

Location _____

Rig up _____

Drilling and Remarks:

*Core 3238**7" C 3239**1000' Water**1200' Oil*

RECORD

Cased _____ in., _____ ft.

Sand _____

Gas _____

Oil _____

Total Depth 3241

PRODUCTION

1st 24 hrs. Nat. _____

1st 24 hrs. after shot _____

Gas _____ Cu. Ft.

Dry Hole _____

Abandoned _____

Date

OCT 4 1939 19S. J. LEWIS Scout