


Section 25 Township 29 Range 5E
Well No. #2 Warner
Company Fell & Wolf

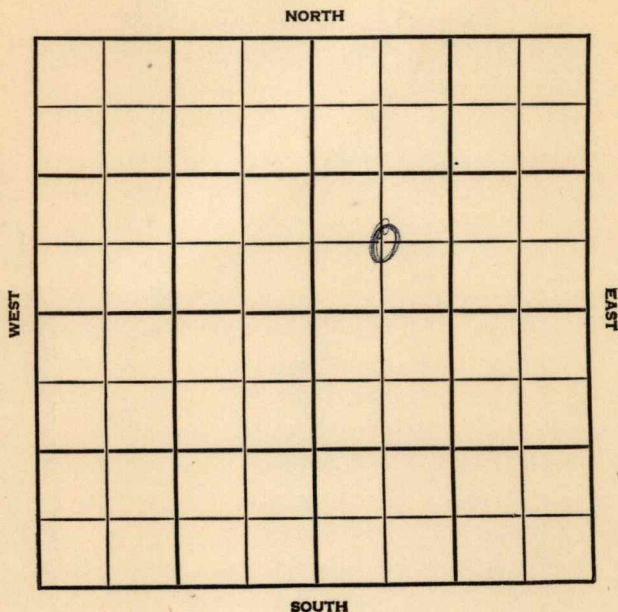

County Butler Elev. 1322 DF
 Sec. 25 Twp. 29 Rge. 5E
 Company Fell & Wolfe
 Farm Name Warner No. 2

TOPS	DEPTH	LOG	DATUM	Loc. in Sec.
Anh.				C SW NE
Tp.				
H.				
Tr.				
Dg.				
BL.				
L.				Geol.
K.C.	2729	2113		Contr.
B.K.C.				Se-Ro-Bee
Ce.				Tools
C.				Pool
M.				Fox-Bush
M.				
K.				
Mz.				
Ma.				
V.				
S.				
S.				
A.				
R.				
Pe.				
G.				
TD.	2749			



Date Comm. spd. 11-3-56

8" @ 100, DST 2113-45, 1 hr, 120' gas, 30'

OCM, no #, Btvl 2725, Core 2735-45 NOV 21 '56 X

correct Barth. to 2729 core correct
 to 2739-49 RTD 2749 5 1/2 @

2729/ CO NOV 28 '56 ✓ DEC 5 '56 ✓ DEC 12 '56

CO DD 2757 1/2 TD Pop.

P. 25 Bopd no wtr.

County Butler Elev. _____
Sec. 25 Twp. 29 Rge. 5E
Company Pell & Wolf
Farm Name Warner No. 2

TOPS	DEPTH	LOG	DATUM	Loc. in Sec.
Anh.				C SW NE
Tp.				
H.				
Tr.				
Dg.				
Bl.				
L.				
K.C.	2113			Geol. _____
B.K.C.				Contr. _____
Ce.				Se-Ro-Bee
C.				Tools
M.				Pool
Mz.				Fox-Bush
Ma.				
V.				
S.				
S.				
A.				
R.				
Pe.				
G.				
T.D.				

Date Comm. spd. 11-3-56
8" @ 100, DST 2113-45, 1 hr, 120' gas, 30'
OCM, no #, Btrl 2725, Core 2735-45

269

NOV 5 0 1956

R.C.