

8/4	2750 - 86	25/15
-----	-----------	-------

Map No. K 11 Sec. 25 Twp. 29 R. 5Well No. 4 WarnerHoney Bay Oil Company

Contractor

SECTION PLAT

1120 Ft. from N. Line

Ft. from S. Line

Ft. from E. Line

1120 Ft. from W. Line

		o	

FIRST REPORT

Location

Rig up

Drilling and Remarks:

J. O. G.

RECORD

Cased in, ft.

Sand

Gas

Oil

Total Depth

PRODUCTION

1st 24 hrs. Nat.

1st 24 hrs. after shot

Gas Cu. Ft.

Dry Hole

Abandoned

Date


3/17 1920

Pyle

Scout

Map No. K 11 Sec. 25 Twp. 29 R. 5Well No. 4 Warner FarmHoney Boy Oil Company.

NORTH

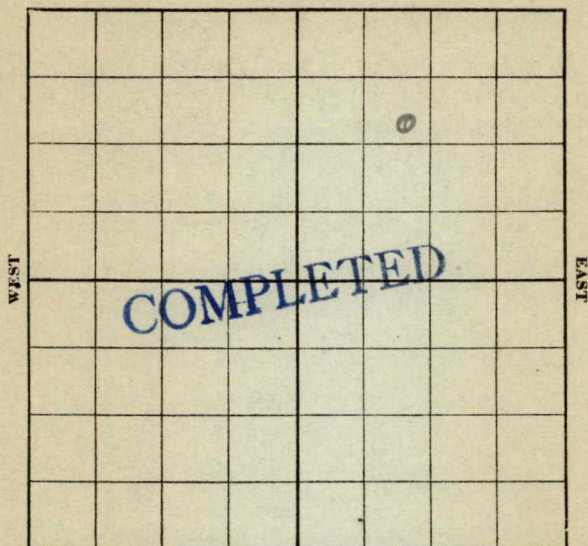

SOUTH

1120 N-W

RECORD

Location

Cased in., ft.

Rig up

Sand 2750-86

Drilling and Remarks:

Gas

Oil

Total Depth

PRODUCTION

1st 24 hrs. Nat.

1st 24 hrs. after shot 75 bbls

Gas Cu. Ft.

Dry Hole

Abandoned

Date

Pyle

Scout.

1920