


Section 18 Township 18 Range 7 W

Well No. #1 Durr

Company Dozier Oil

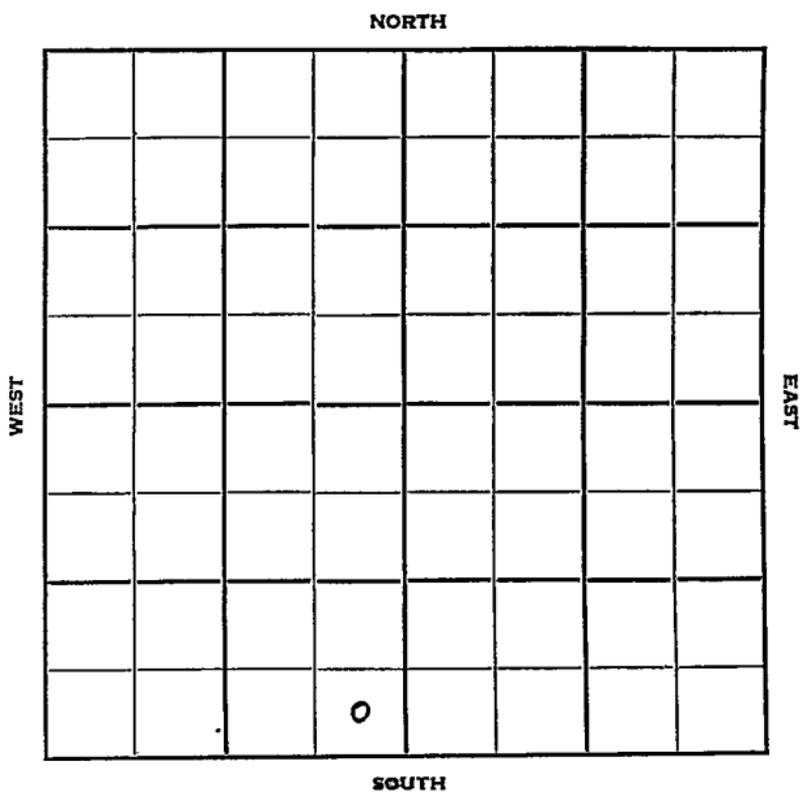

Rice
18

KANSAS

7W

Sec. 18 Twp.

R.

Well No. #1 Durr Farm

Dozier Oil Company

Geneseo Pool Contractor


Ft. from N. Line

330' Ft. from S. Line

330' Ft. from E. Line

Ft. from W. Line

SE SE SW

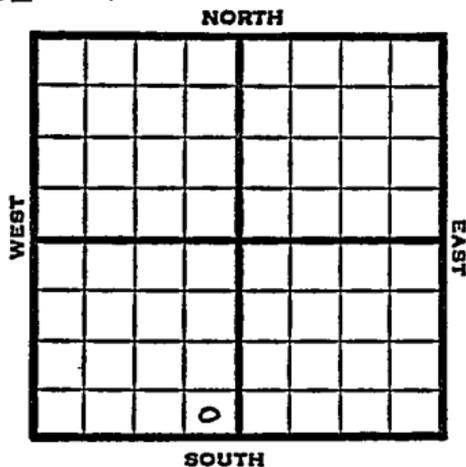

1951

Elev. 1691' REPORT

1/31

Location

3/7

D&A TD 3265
 8" @ 203 Heeb. 2608
 Toronto 2637
 Br Lime 2738 Lans. 2768
 Cong. 3141' Simp. 3226
 TD 3265

D&A

ABANDONED

