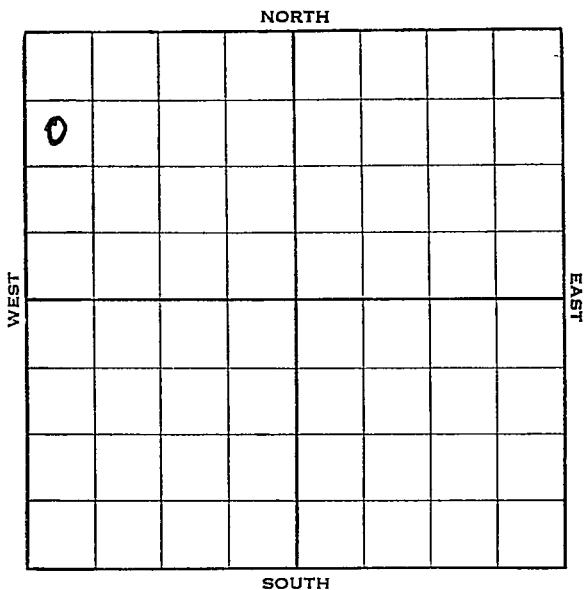


C. W. P. B.

Rice

KANSAS

Section 18 Township 18 Range 7-WWell No. 2 SiemsenCompany Continental

KANSAS

Rice O. W. P. B. ✓

Sec. 18 Twp. 18 R. 7-W

Well No. #2 Siemsen Farm

Continental Company

(Geneseo)


990 Ft. from N. Line

Ft. from S. Line

Ft. from E. Line

330 Ft. from W. Line

Elev. 1730 SW NW NW

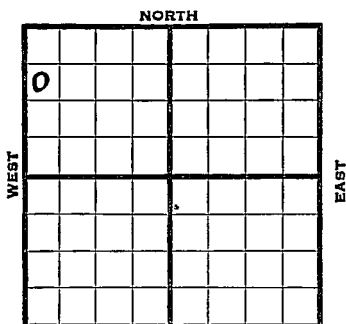

	REPORT
1939	
1/4	B.R.R.
1/13	10" - 205' Drlg. 1675'.
1/20	Arb. 3203 3203-3215 S. O.
	7" - 3204 3203 RUST.
1/27	3215 equals 3210'.
	Arb. 3203' (Corrected)
	7" - 3204' "
	T. D. 3212'. 3000' oil.
2/1	7" - 3204'.
	Arb. 3203'.
	T. D. 3212'.
	2000 acid.
	Potential 2609 bbls.
	No water.
	COMPLETED
	OVER

O. W. P. B.

1953

12/16 KC 2794', Arb. 3207'
OTD 3212'
7" @ 3204'
PB 3163'
42/2866-80',
S/2 bwph 500A
S/12 bwph
PB 2854'
42.2812-26, tstg.

12/22 D&A

TD 3212'
KC 2794', Arb. 3207'
OTD 3212'
7" @ 3204'
PB 3163'
42/2866-80', S/2 bwph 500A
S/12 bwph
PB 2854'
42/2812-26
D&A

ABANDONED

Rice

KANSAS

Map No. 45 Sec. 18 Twp. 18 R. 7WWell No. 2 SiemsenContinental Company

Contractor

FIRST REPORT

SECTION PLAT

990 SW NW NW
Ft. from N. Line

Ft. from S. Line

Ft. from E. Line

330 Ft. from W. Line

GENESEO, POOL

O			

Location

Rig up

Drilling and Remarks:

BRR

RECORD

Cased _____ in., _____ ft.

Sand _____

Gas _____

Oil _____

Total Depth _____

PRODUCTION

1st 24 hrs. Nat. _____

1st 24 hrs. after shot _____

Gas _____ Cu. Ft.

Dry Hole _____

Abandoned _____

Date

JAN 4 - 1932 19 H. D. Hatfield Scout

Rice

KANSAS

Map No. _____ Sec. 18 Twp. 18 R. 7WWell No. 2 SiemsenContinental Company

Contractor

COMPLETED

SW NW NW

990 Ft. from N. Line

_____ Ft. from S. Line

_____ Ft. from E. Line

330 Ft. from W. Line

GENESEO POOL

SECTION PLAT

0			

Location _____

Rig up _____

Drilling and Remarks:

*2000 acid**Pot 2609**No wTr*

RECORD

Cased 7 in., 3204 ft.Sand 416 3203

Gas _____

Oil _____

Total Depth 3212

PRODUCTION

1st 24 hrs. Nat. _____

1st 24 hrs. after shot _____

Gas _____ Cu. Ft.


Dry Hole _____

Abandoned _____

Date

FEB 1 - 1939 19H. D. Hatfield Scout

O. W. P. B.

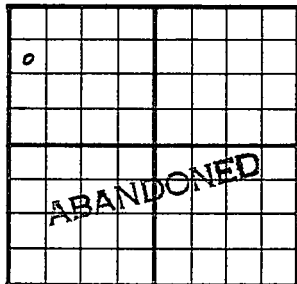County Rice State KansasSec. 18 (Blk. Twp.) 18 (Sur. Rge.) 7W Map No.Operator Continental OilWell No. 2 Farm D. M. SiemsenElev. 1730 Location SW NW NW990 Ft. From N Line NW330 Ft. From W Line Quarter

1st. Report

DEC 22 1953

Completion

Remarks OWPB

O. W. P. B.

Spudding Date

Drlg. Data D & A TD 3212KC 2794 Arb. 3207 OTD 3212 7" @ 3204PB 3163 42/ 2866-80 S/ 2 bwph 500 AS/ 12 bwph PB 2854 42/ 2812-26D & A

J. G. McGEHEE

O. W. P. B.

County Rice State KansasSec. 18 (Blk. 18 (Sur. 7W (Twp. 18 (Rge. 7W Map No. 18Operator Continental OilWell No. 2 Farm D. M. SiemsenElev. 1730 Location SW NW NW

0							

990 Ft. From N Line NW330 Ft. From W Line Quarter1st. Report DEC 16 1953Completion Remarks OWPBSpudding Date Drilg. Data Geese PoolKC 2794 Arb. 3207 OTD 3212 7" @ 3204PB 3163 42/ 2866-80 S/ 2 bwph 500 AS/ 12 bwph PB 2854 42. 2812-26 tstg.

J. G. McGEHEE