

O.W.W.O.

Form 51-5M-11-38-Palace

Rice


KANSAS

Section 18 Township 18 Range 7-W

Well No. #4 Siemsen

Company Continental

NORTH Geneseo Pool

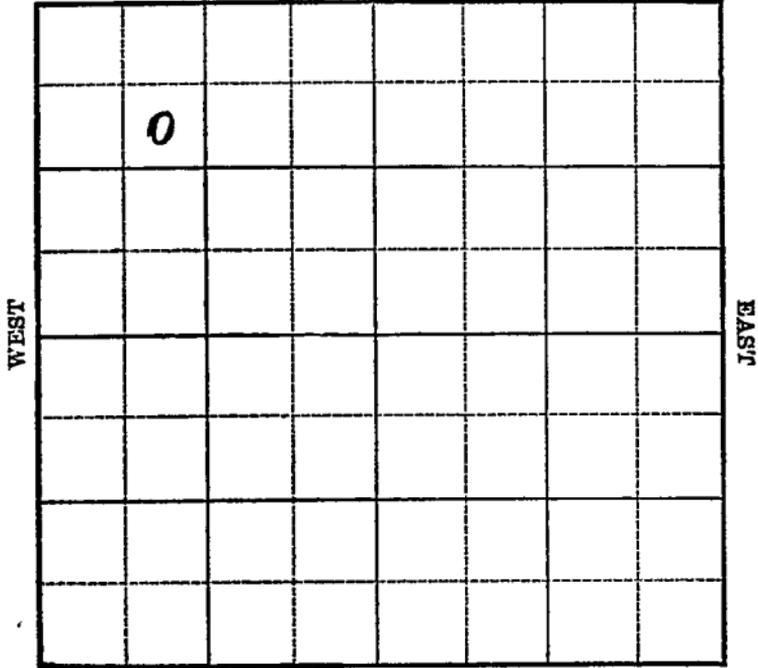

SOUTH

O.W.W.O. KANSAS

Rice ✓

Sec. 18 Twp. 18 R. 7-W

Well No. #4 Siemens Farm

Continental Company

(Geneseo)

990 Ft. from N. Line


Ft. from S. Line

Ft. from E. Line

990 Ft. from W. Line

SE NW NW

Elev. 1725

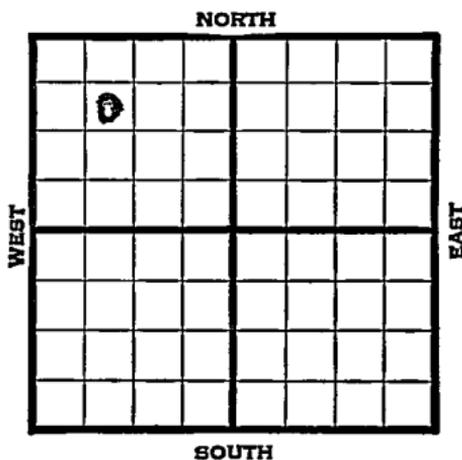

1939	REPORT
6/28	Rotary.
7/6	"
7/13	10" - 210' Drlg. 1450'
7/20	Drlg. 3179'
7/27	Arb. 3220' S.O. 7" - 3221'
	T.D. 3225' 2000' oil 7 hours.
8/2	Arb. 3220'
	T.D. 3225'
	7" - 3220'
	1000 acid.
	Potential 1938 bbls. pump.
COMPLETED	
1952	O.W.W.O.
11/26	D & A TD 3225' Lans. 2790'
	Simp 3195' Arb. 3220' OTD 3225'
	7" @ 3221 PB 3210' 32/3192-3200
	dry. 64/2968-76 2980-88 B/1/2 BWPH
	1/2937 48/2882-2908 S/4 BWPH
	30/ 2860-70 S/5 BWPH 36/2800-2812
	S/6 BWPH D & A
	FIRST REPORT
	ABANDONED

Map No. 45 Sec. 18 Twp. 18 R. 7WWell No. 4 SiemsenContinental

Company

Contractor

FIRST REPORT

SECTION PLAT

SE NW NW

990 Ft. from N. Line

_____ Ft. from S. Line

_____ Ft. from E. Line

990 Ft. from W. Line

0			

GENESEO POOL

Location _____

Rig up _____

Drilling and Remarks:

Rotary

RECORD

Cased _____ in., _____ ft.

Sand _____

Gas _____

Oil _____

Total Depth _____

PRODUCTION

1st 24 hrs. Nat. _____

1st 24 hrs. after shot _____

Gas _____ Cu. Ft.

Dry Hole _____

Abandoned _____

Date

JUN 28 1939

19

S. J. LEWIS

Scout

Map No. 45 Sec. 18 Twp. 18 R. 7WWell No. 4 SiemsenContinental

Company

Contractor

COMPLETED**SECTION PLAT**990 SE NW NW
Ft. from N. Line

Ft. from S. Line

Ft. from E. Line

990 Ft. from W. Line

o			

GENESEO POOL

Location _____

RECORD

Cased _____ in., _____ ft.

Sand _____

Gas _____

Oil _____

Total Depth 3225**PRODUCTION**

1st 24 hrs. Nat. _____

1st 24 hrs. after shot _____

Gas _____ Cu. Ft.

Dry Hole _____

Abandoned _____

Rig up _____

Drilling and Remarks: *

*cu 3220**7" @ 3220**1000 acid**Pump 1938 P.H.*

Date

AUG 2 1939 19

S. J. LEWIS

Scout

O.W.W.O.


County **Rice** State **Kansas**

Sec. **18** (Blk. Twp.) **18** (Sur. Rge.) **7W** Map No.

Operator **Continental Oil**

Well No. **4** Farm **Siemsen**

Elev. **1725** Location **SE NW NW**

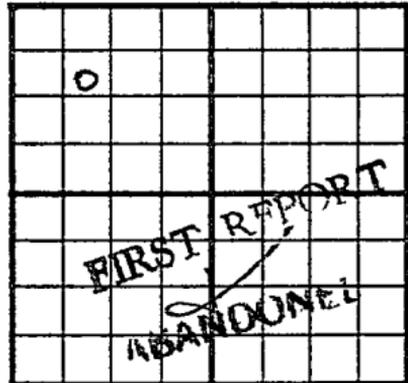

990 Ft. From **N** Line **NW**

990 Ft. From **W** Line **Quarter**

Ist. Report **NOV 26 1952**

Completion **NOV 26 1952**

Remarks **O.W.W.O.**
O.W.W.O.

Spudding Date

Drlg. Data **D & A** **TD 3225**

Lens. 2790 Simp. 3195 Arb. 3220

OTD 3225 7" @ 3221 PB 3210 32/ 3192-

3200 dry 64/ 2968-70 2980-88

B/ 1/2 bwph 1/ 2937 48/ 2882-2908

S/ 4 bwph 30/ 2860-70 S/ 5 bwph

36/ 2800-2812 S/ 6 bwph

D & A

J. G. McGEHEE