KANSAS

Form 51—5M—7-40—Palace


Rice

Section 19 Township 18 Range 7-W

Well No. 2 Gray

Company Continental

Geneseo Pool

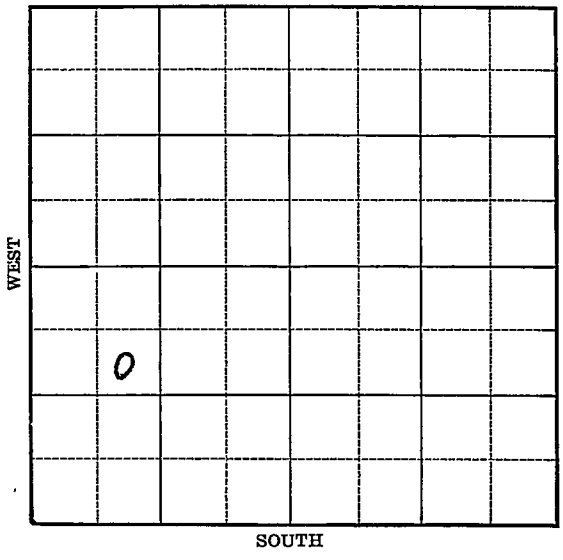

FORM 252-A 5M 7-40 PETROL KANSAS Rice

Sec. 19 Twp. 18 R. 7-W

Well No. #2 Gray Farm

Continental Company


(Geneseo)

990 Ft. from N. Line

Ft. from S. Line

Ft. from E. Line

990 Ft. from W. Line

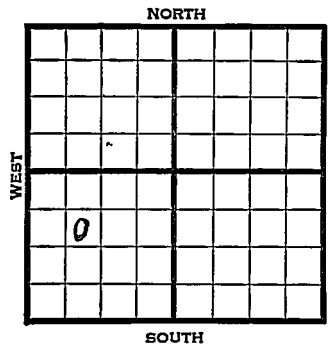

Elev. 1723

1941	REPORT
1/8	Derrick.
1/16	10" - 209' Drlg. 1409'
1/23	Drlg. 3130'
1/30	Arb. 3141' 6" - 3142'
	Drlg. 3178' 3000' oil.
2/6	T.D. 3203' 3050' oil.
2/12	Arb. 3141'
	6" - 3142'
	T.D. 3203'
	Echo. potential 13,162 bbls.
	Maximum 3000 bbls.
	40.1 Gravity
	COMPLETED

Form 26—200 Bks.—1-40—Palace Rice KANSAS

Map No. 45 Sec. 19 Twp. 18 R. 7W

Well No. 2 Gray

Continental Company

Contractor

FIRST REPORT

SE NW SW

990 Ft. from N. Line


Ft. from S. Line

Ft. from E. Line

990 Ft. from W. Line

GENESEO POOL

SECTION PLAT

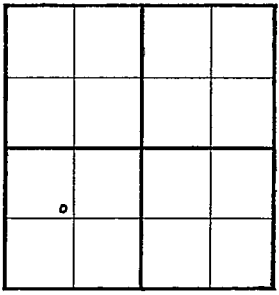

Location

Rig up

Drilling and Remarks:

Derrick

RECORD

Cased in., ft.

Sand

Gas

Oil

Total Depth

PRODUCTION

1st 24 hrs. Nat.

1st 24 hrs. after shot

Gas Cu. Ft.

Dry Hole

Abandoned

Date

JAN 8 1941

19

S. J. LEWIS Scout

Form 26—200 Bks.—1-40—Palace Rice KANSAS

Map No. 45 Sec. 19 Twp. 18 R. 7W

Well No. 2 Gray

Continental Company

Contractor

COMPLETED

SE NW SW

990 Ft. from N. Line


Ft. from S. Line

Ft. from E. Line

990 Ft. from W. Line

GENESEO POOL

SECTION PLAT

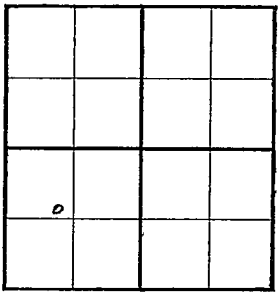

Location

Rig up

Drilling and Remarks:

Cas 3141

6" @ 3142

Echo Pay 3162

May 8000

40 - Gr.

RECORD

Cased in., ft.

Sand

Gas

Oil

Total Depth 8203

PRODUCTION

1st 24 hrs. Nat.

1st 24 hrs. after shot

Gas / Cu. Ft.

Dry Hole

Abandoned

Date

FEB 12 1941 19

S. J. LEWIS Scout