


Map No. _____ Sec. 25 Twp. 29 R. 5
Well No. 2 Warner Farm _____
Honey Bay Company _____

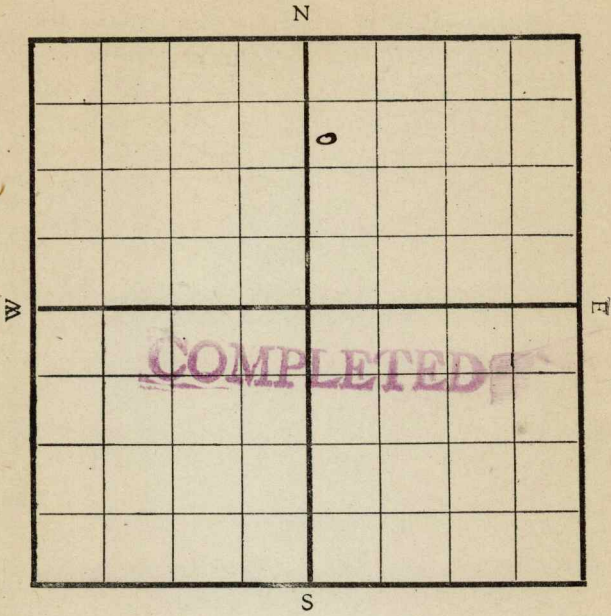

Location _____
Drilling Remarks:

Rig Up _____
Drilling Remarks:

RECORD

Cased _____ in. _____ ft.
Sand _____
Gas _____
Oil _____
Total Depth _____

PRODUCTION

1st 24 hrs. Nat. _____
1st 24 hrs. after shot _____
Gas _____ cu. ft.
Dry Hole _____
Abandoned _____

Map No. K11 Sec. 25 Twp. 29 R. 5Well No. 2 WarnerHoney Bay O & L Company

Contractor

SECTION PLAT

990 Ft. from N. Line

Ft. from S. Line

Ft. from E. Line

330 Ft. from W. Line

Location

Rig up

Drilling and Remarks:

200'

RECORD

Cased _____ in., _____ ft.

Sand _____

Gas _____

Oil _____

Total Depth _____

PRODUCTION

1st 24 hrs. Nat. _____

1st 24 hrs. after shot _____

Gas _____ Cu. Ft.

Dry Hole _____

Abandoned _____

Date

11/9 1919

Pyle

Scout

Map No. K 11 Sec. 25 Twp. 29 R. 5Well No. 2 WarnerHoney Boy Oil Company

Contractor

SECTION PLAT

990 Ft. from N. Line

Ft. from S. Line

Ft. from E. Line

330 Ft. from W. Line

COMPLETED

Location

Rig up

Drilling and Remarks:

RECORD

Cased _____ in., _____ ft.

Sand 2760-2804

Gas _____

Oil _____

Total Depth _____

PRODUCTION

1st 24 hrs. Nat. 100 bbls

1st 24 hrs. after shot _____

Gas _____ Cu. Ft.

Dry Hole _____

Abandoned _____

Date

2/21 1920

Pyle

Scout