


O. W. P. B.

Section 19 Township 18 Range 7-W

Well No. #3 Gray

Company Continental et al

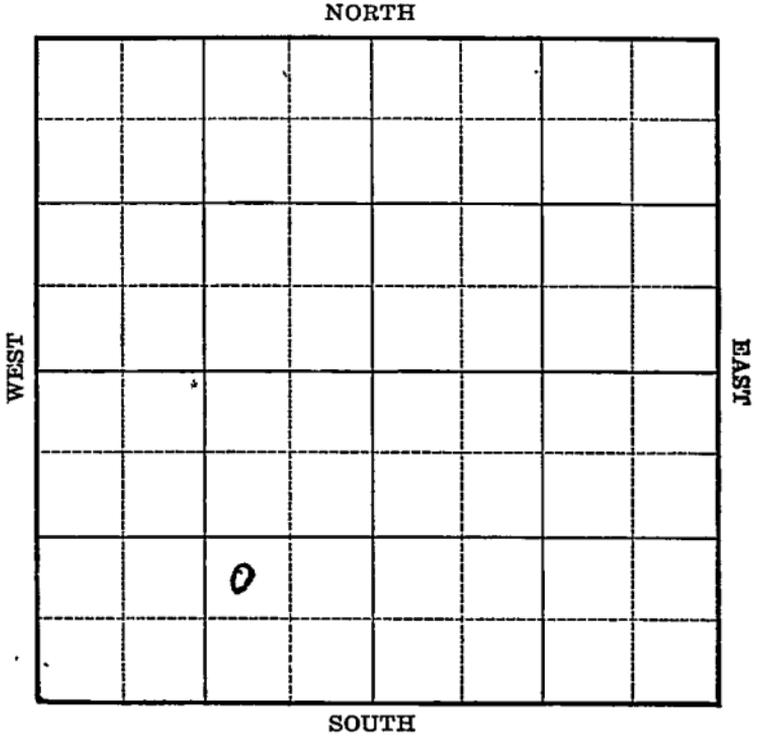

O. W. P. B.

Sec. 19 Twp. 18 R. 7-W ✓

Well No. #3 Gray Farm _____

Continental et al Company _____

(Beneseo)


_____ Ft. from N. Line

99.0 Ft. from S. Line

99.0 Ft. from E. Line

_____ Ft. from W. Line

Nw Se sw Elev. 1712

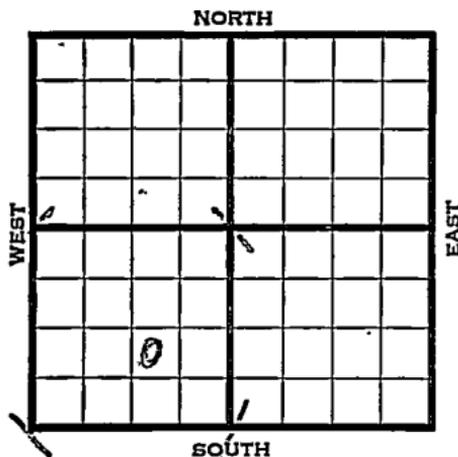

1941	REPORT
2/12	Location
2/20	9" - 211' WOC.
2/27	Drig. 3030'
3/6	Arb. 3172' 6" - 3173' T.D. 3192' Swab 256 oil in 4 hours.
3/12	Arb. 3201' 6" - 3202' T.D. 3214' 2000 acid. Echometer potential 6170 bbls. Maximum 3000 bbls. 40.1 Gravity
COMPLETED	
OVER	

1954
3/10

D&A
TD 3192'
Lans 2768', B KC 3071', Simp. 3124',
Arb. 3172'
OTD 3192'
PB 3160
27/3140-50
B/ $\frac{1}{2}$ bw 33/3123-34
B/ $\frac{1}{3}$ bw, frac,
S/wtr
PB 3110'
17/2988-96
B/ $\frac{1}{2}$ bw
45/2872-94 wtr w/SSO
PB 2860
18/2790-2801
B/ $\frac{1}{4}$ bw
7/2654-95, 12/2635-45
D&A

FIRST REPORT

ABANDONED

O. W. P. B.

County Rice State Kansas

Sec. 19 (Blk. Twp.) 18 (Sur. Rge.) 7W Map No.

Operator Continental Oil

Well No. 3 Farm B. C. Gray

Elev. 1712 Location NW SE SW

FIRST REPORT					
ABANDONED					

990 Ft. From S Line SW

990 Ft. From 12 Line Quarter

1st. Report MAR 1 0 1954

Completion MAR 1 0. 1954

Remarks OWPB

Spudding Date O. W. P. B.

Drig. Data D & A TD 3192

Lens. 2768 B KC 3071 Simp. 3124

Arb. 3172 OTD 3192 PB 3160 27/ 3140-50

B/ 1/2 bw 33/ 3123-34 R/ 3 bw frac

S/ wtr PB 3110 17/ 2988-96 B/ 1/2 bw

45/ 2872-94 wtr. W/ SSO PB 2860

18/ 2790-2801 B/ 4 bw 7/ 2654-95

12/ 2635-45

D & A

J. G. McGEHEE