

KANSAS

FORM 51 5M 1-42 PETROL


Rice

Section 19 Township 18 Range 7-W

Well No. #5 Gray

Company Continental

NORTH Geneseo Pool

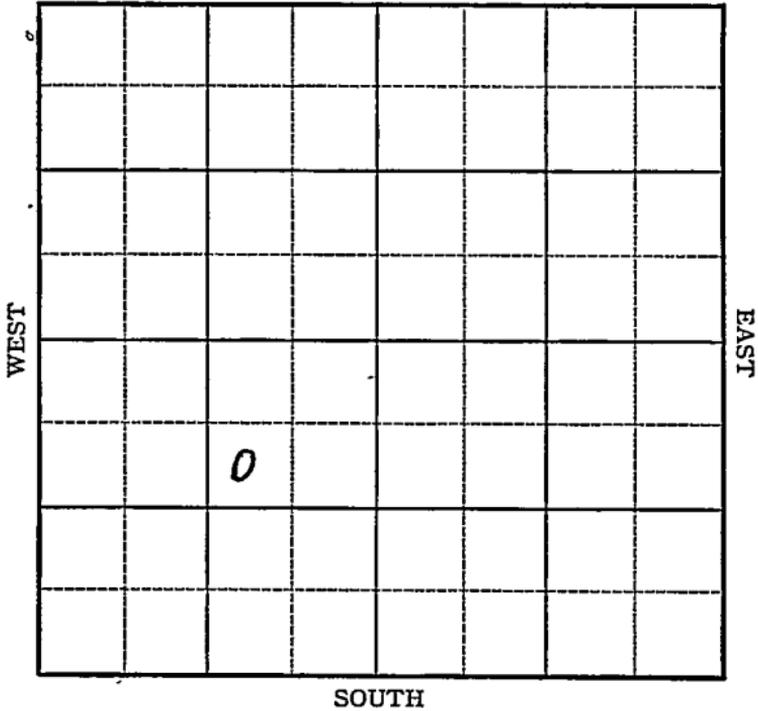

Sec. 19 Twp. 18 R. 7-W

Well No. #5 Gray Farm _____

Continental Company

(Geneseo)


990 Ft. from N. Line

_____ Ft. from S. Line

990 Ft. from E. Line

_____ Ft. from W. Line

Elev. 1719

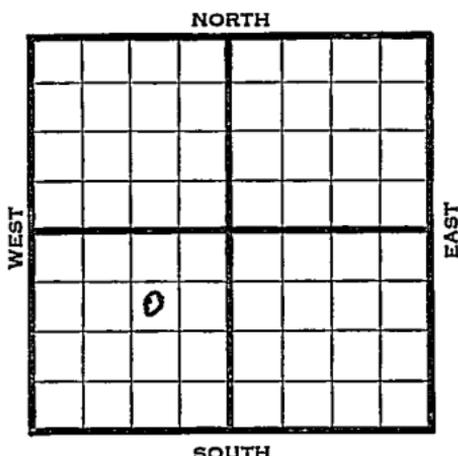

1942

REPORT

2/11

Surface hole.

2/19

10" - 214' Drlg. 2623'

2/26

Arb. 3175' T.D. 3179' 6" - 3176'

RUST*

3/4

Arb. 3175'

6" - 3176'

T.D. 3200'

Echometer potential 6488 bbls.

Maximum 3000 bbls.

39. Gravity

COMPLETED

Rice

KANSAS

Map No. 45 Sec. 19 Twp. 18 R. 7WWell No. 5 GrayContinental Company**COMPLETED**

Contractor

SECTION PLAT

SW NE SW

990 Ft. from N. Line

Ft. from S. Line

990 Ft. from E. Line

Ft. from W. Line

| | | | |
|--|--|--|--|
| | | | |
| | | | |
| | | | |
| | | | |
| | | | |

GENESEO POOL

Location _____

Rig up _____

Drilling and Remarks:

Cur 81756" @ 3176Echo 26488Max 300039° SW

RECORD

Cased _____ in., _____ ft.

Sand _____

Gas _____

Oil _____

Total Depth 3200

PRODUCTION

1st 24 hrs. Nat. _____

1st 24 hrs. after shot _____

Gas _____ Cu. Ft.

Dry Hole _____

Abandoned _____

Date

MAR 4 1942 19S. J. LEWIS Scout