

Map No. Sec. Twp. R.

Well No. Farm


..... Company

..... Ft. from N. Line

..... Ft. from S. Line

..... Ft. from E. Line

..... Ft. from W. Line

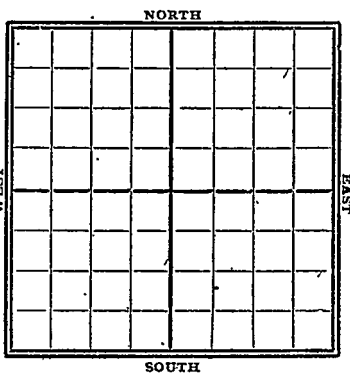

1926

Date

REPORT

Gypsy Records

1/12

*HFW { 3756'
 { 3762' TD
Abandoned*

Shannon
K1 MAP No. KANSAS SEC. 34 TWP. 34S R. 2E

WELL No. 1 Mc Ewen

Prarie COMPANY

CONTRACTOR

SECTION PLAT

ABANDONED

_____ FT. FROM N. LINE

_____ FT. FROM S. LINE

_____ FT. FROM E. LINE

_____ FT. FROM W. LINE

U.K.

LOCATION _____

RIG UP _____

DRILLING AND REMARKS:

*3756 H.E. W
3768*

RECORD

CASED _____ IN. _____ FT.

SAND _____

GAS _____

OIL _____

TOTAL DEPTH 2700

PRODUCTION

1ST 24 HRS. NAT. _____

1ST 24 HRS. AFTER SHOT _____

GAS _____ CU. FT.

DRY HOLE

ABANDONED

DATE

1/17 1926

SCOUT