

Map No. KANSAS Sec. 5 Twp. 33 R. 4^S 4^E

Well No. 101 Ranch So Farm _____ Company _____

NORTH

				0			

WEST

EAST

SOUTH

Location.....

Drilling Remarks

.....

.....

Rig Up.....

Drilling Remarks

.....

.....

RECORD

Cased..... in..... ft.

Sand.....

Gas.....

Oil.....

Total Depth.....

PRODUCTION

1st 24 hrs. Nat.....

1st 24 hrs. after shot.....

Gas..... cu. ft.....

Dry Hole.....

Abandoned.....

Map No. Sec. Twp. R.

Well No. Farm


..... Company

..... Ft. from N. Line

..... Ft. from S. Line

..... Ft. from E. Line

..... Ft. from W. Line

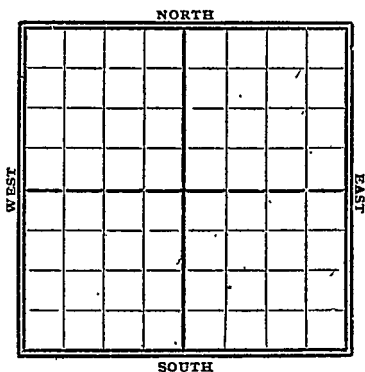

1914

Date

REPORT

Gypsy Records

9/19

Abd T.D. 2539'

Cowley

MAP NO. K2 KANSAS SEC. 2 TWP. 33S R. 4E

WELL NO. 101 Ranch Co. COMPANY

CONTRACTOR

ABANDONED

SECTION PLAT

		0	

_____ FT. FROM N. LINE

_____ FT. FROM S. LINE

_____ FT. FROM E. LINE

_____ FT. FROM W. LINE

no record

RECORD

LOCATION _____

RIG: UP _____

DRILLING AND REMARKS:

CASED _____ IN. _____ FT.

SAND _____

GAS _____

OIL _____

TOTAL DEPTH 2539

PRODUCTION

1ST 24 HRS. NAT. _____

1ST 24 HRS. AFTER SHOT _____

GAS _____ CU. FT.

DRY HOLE

ABANDONED

DATE

9-19 1924

SCOUT