



Map No. T. 11 Sec. 25 Twp. 29 R. 5


Well No. 5 Warner Farm  
Honey Boy Company

200 Ft. from N. Line

\_\_\_\_\_ Ft. from S. Line

\_\_\_\_\_ Ft. from E. Line

660 Ft from W. Line

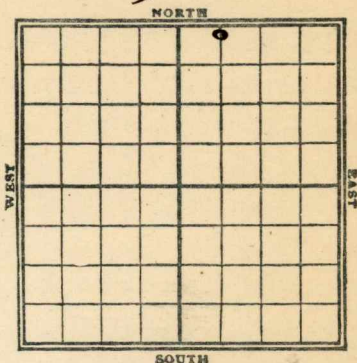

Date  
1/10  
8/25  
8/29  
9/16  
1921  
1/30

REPORT REPORT

Dig up

Dig

12" - 800

2778 - 2800 -  
shot 20 gts / 35 lbs.

COMPLETED

Map No. K11 Sec. 25 Twp. 29 R. 5

Well No. 5 Warner  
Honey Boy Company

Contractor

SECTION PLAT

200 Ft. from N. Line

----- Ft. from S. Line

----- Ft. from E. Line

660 Ft. from W. Line

		○	

FIRST REPORT

Location -----

Rig up -----

Drilling and Remarks:

RECORD

Cased ----- in., ----- ft

Sand -----

Gas -----

Oil -----

Total Depth -----

PRODUCTION

1st 24 hrs. Nat. -----

1st 24 hrs. after shot -----

Gas ----- Cu. Ft.

Dry Hole -----

Abandoned -----

Date

8/25 19120

Pyle

Scout

Map No. K 11 Sec. 25 Twp. 29 R. 5

Well No. 15 Warner

Honey Boy Company

Contractor

SECTION PLAT

200 Ft. from N. Line

----- Ft. from S. Line

----- Ft. from E. Line

660 Ft. from W. Line

		0	

COMPLETED

Location -----

Rig up -----

Drilling and Remarks:

Shot 20 gts

RECORD

Cased ----- in., ----- ft.

Sand 2778-2800

Gas -----

Oil -----

Total Depth -----

PRODUCTION

1st 24 hrs. Nat. -----

1st 24 hrs. after shot 550

Gas ----- Cu. Ft.

Dry Hole -----

Abandoned -----

Date

Jan 30 1921

Pyle

Scout