


Russell KANSAS

Section 15 Township 15 Range 14 WWell No. # 5 KrugCompany Phillips Pet.

NORTH

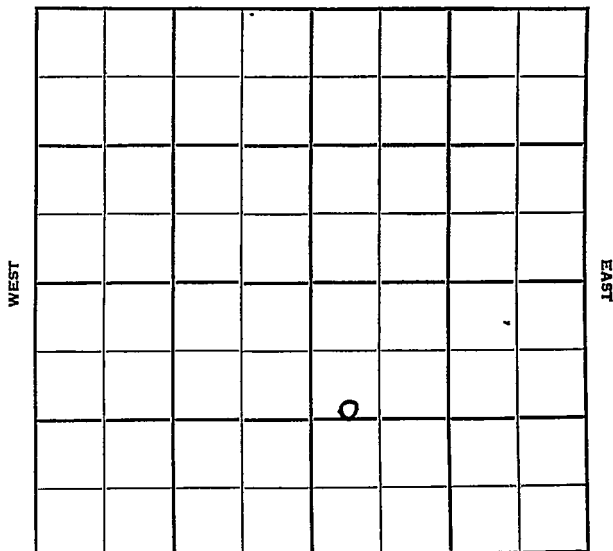

SOUTH

Russell

KANSAS

Sec. 15 Twp. 15 R. 14W

Well No. #5 Krug Farm

Phillips Pet. Company

Wolffard Contractor

Trapp Pool


Ft. from N. Line

1370 Ft. from S. Line

Ft. from E. Line

330 Ft. from W. Line

C S L SW NW SE

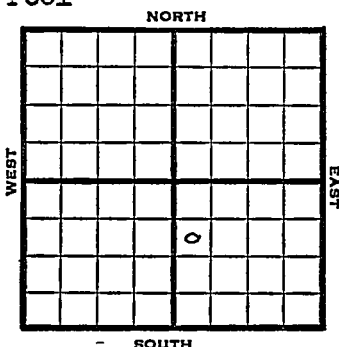

1952

Elev. 1818' REPORT

3/19
3/25

Cellar & Pits

8" @ 555'

Drlg. 1540'

4/1

Anhy 850

Tarkio 2458

Heeb. 2956

Tor. 2974

Lans. 3019

Drlg. 3050'

4/9

BKC 3250

Arb. 3267-3272 TD

5" @ 3269 Bailing mud

4/23

DP CO to 3272' TD. Fill up 1800' oil
7 hrs. S/89 BO 5 hrs. POP

4/30

Spud 3-20-52

Oil well TD 3272' 8" @ 555'

Anhy 850' Tarkio 2458' Heeb 2956'

Tor. 2974' Lans. 3019' B KC 3250'

Arb. 3267-72 5" @ 3269 TD 3272

FU 1800' oil 7 hr. S/89 BO 5 hr.

Comp. 411 BOPD

COMPLETED



Sec. 15 (Blk.) 15 (Sur.) 14W Map No.

Well No. **5** Farm **Krug**

Elev.	Location	C	S	L	SW	NW	SE
-------	----------	---	---	---	----	----	----

FIRST REPORT

1370 Ft. From S Line SE

330 Ft. From W Line Quarter

1st. Report MAR 19 1952

Completion

Remarks

Wolffard - Contr.

Spudding Date

Drlg. Data

Trapp Pool


Cellar & pits

County Russell State Kansas
 Sec. 15 (Blk. 15 (Sur. 14W Map No.
 Twp.) Rge.)

Operator Phillips Pet.

Well No. 5 Farm Krug

Elev. 1818 Location C S L SW NW SE

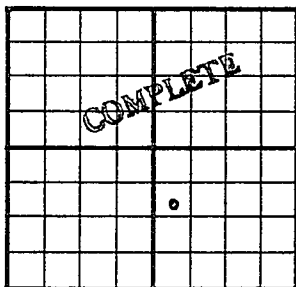

1370 Ft. From S Line SE

330 Ft. From W Line Quarter

1st. Report

Completion APR 30 1952

Remarks Trapp Pool

Wolffard - Contr.

Spudding Date 3-20-52

Drlg. Data Oil well TD 3272

8" @ 555 Anhy 850 Tarkio 2458

Heeb. 2956 Tor. 2974 Lans. 3019

B KC 3250 Arb. 3267-72 5" @ 3269

TD 3272 FU 1800' oil 7 hr.

S/ 89 bo 5 hr. Comp. 411 bopd