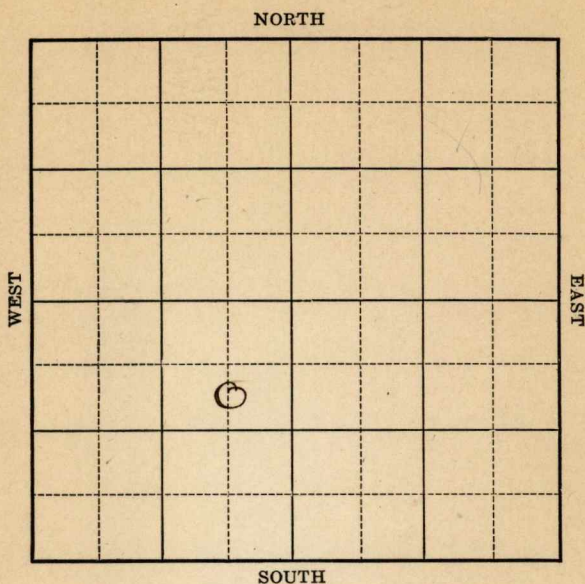


Map No. 5 Sec. 25 Twp. 29 R. 5
Well No. 9 Warner Farm
Elmo Oil Company



Location _____ **COMPLETED** Rig Up _____

Drilling Remarks: _____

RECORD

Cased _____ in. _____ ft.

Sand _____

Gas _____

Oil _____

Total Depth _____

PRODUCTION

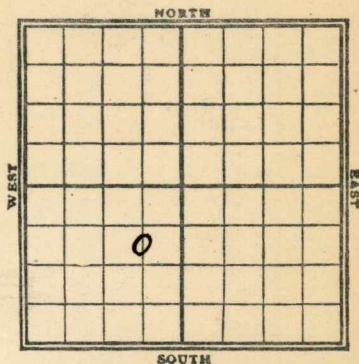
1st 24 hrs. Nat. _____

1st 24 hrs. after shot _____

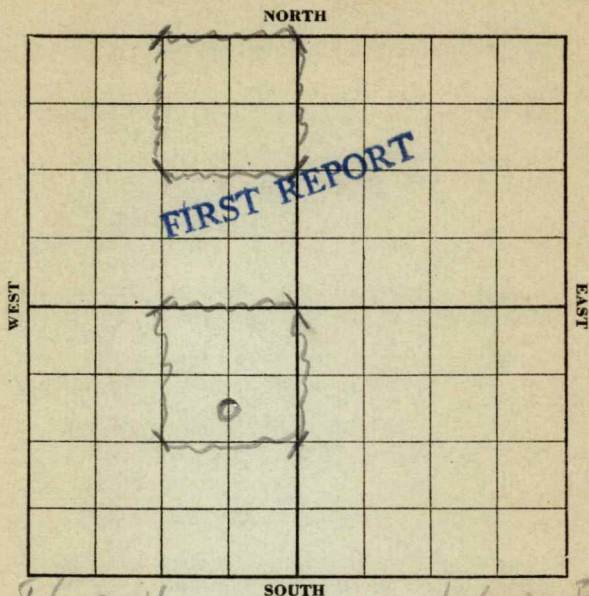
Gas _____ cu. ft.

Dry Hole _____

Abandoned _____

Map No. K.11 Sec. 25 Twp. 29 R. 5Well No. P Warner Farm
Elmo Oil Company860 Ft. from N. Line Ft. from S. Line860 Ft. from E. Line Ft. from W. LineDate
1920FIRST REPORT
REPORT8/4 Tools8/10 Spud8/29 S. 10. @ 480'9/16 240010/21 2717-70- 30/35

COMPLETED

Map No. K11 Sec. 25 Twp. 29 R. 5Well No. 9 Warner FarmElma Oil Company.860 H

SOUTH

660 E

Location

Rig up

Drilling and Remarks:

Tools

RECORD

Cased in., ft.

Sand

Gas

Oil

Total Depth

PRODUCTION

1st 24 hrs. Nat.

1st 24 hrs. after shot

Gas Cu. Ft.

Dry Hole

Abandoned

Date

8/14 1920**Pyle**

Scout.

Map No. K11 Sec. 25 Twp. 29 R. 5Well No. 9 WarnerElma Oil Company

Contractor

SECTION PLAT

860 Ft. from N. Line

Ft. from S. Line

660 Ft. from E. Line

Ft. from W. Line

Location

Rig up

Drilling and Remarks:

Shot 30 qt

RECORD

Cased _____ in., _____ ft.

Sand 2717-70

Gas _____

Oil _____

Total Depth _____

PRODUCTION

1st 24 hrs. Nat. _____

1st 24 hrs. after shot 35 B

Gas _____ Cu. Ft.

Dry Hole _____

Abandoned _____

Date

10/20 1921Pyle Scout