




Map No. Kansas Sec. 14 Twp. 25 R. 13^E

Well No. 1 Mason Farm
Superior Oil Co. Company

NORTH

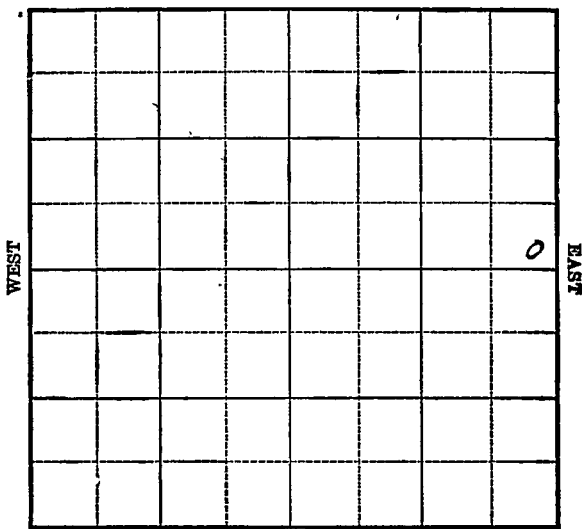

SOUTH

Location _____

Rig Up _____

Drilling Remarks:

Drilling Remarks:

RECORD

PRODUCTION

Cased _____ in. _____ ft.

1st 24 hrs. Nat. _____

Sand _____

1st 24 hrs. after shot _____

Gas _____

Gas _____ cu. ft.

Oil _____

Dry Hole _____

Total Depth _____

Abandoned _____

Map No. 14 Sec. 14 Twp. 25 R. 13^E

Well No. 1

Superior Oil Co Company

Contractor

FIRST REPORTS

SECTION PLAT

_____ Ft. from N. Line

200 Ft. from S. Line

200 Ft. from E. Line

_____ Ft. from W. Line

			0

Location _____

Rig up _____

Drilling and Remarks:

s/d 1395'

RECORD

Cased _____ in., _____ ft.

Sand _____

Gas _____

Oil _____

Total Depth _____

PRODUCTION

1st 24 hrs. Nat. _____

1st 24 hrs. after shot _____

Gas _____ Cu. Ft.

Dry Hole _____

Abandoned _____

Date

APR 10 1925

Chas. L. Sherwood
Scout

Map No. 10th Sec. 14 Twp. 25 R. 13

Well No. 1 Moran

Superior Oil Co Company

Contractor

COMPLETED

SECTION PLAT

----- Ft. from N. Line

200 Ft. from S. Line

200 Ft. from E. Line

----- Ft. from W. Line

ABANDONED

Location -----

Rig up -----

Drilling and Remarks:

*My hand
40 1520'*

RECORD

Cased ----- in., ----- ft.

Sand -----

Gas -----

Oil -----

Total Depth 1520

PRODUCTION

1st 24 hrs. Nat. -----

1st 24 hrs. after shot -----

Gas ----- Cu. Ft.

Dry Hole

Abandoned

Date

APR 24 1925

192

Chas. L. Howwood Scout