


KANSAS

Russell

Section 15 Township 15 Range 14WWell No. 3 MaiCompany Phillips

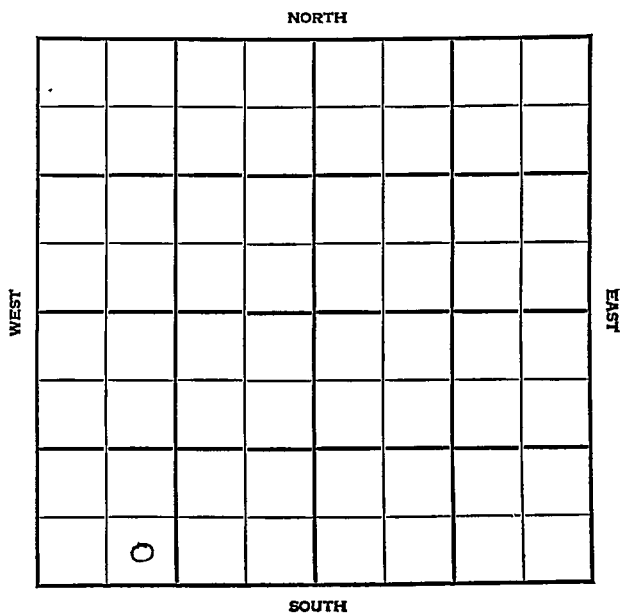

Sec. 15 Twp. 15 R. 14W

Well No. #3 Mai Farm

Phillips Company

Trapp


 Ft. from N. Line

330 Ft. from S. Line

 Ft. from E. Line

990 Ft. from W. Line

SE SW SW

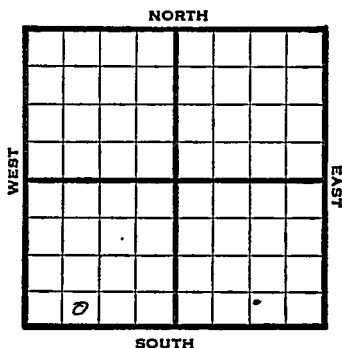

1948 Elev. 1880' REPORT

4/28 Location

5/5 RUR

5/12 8" @ 948'
Drlg. 1000'

5/19 Topeka 2796'
Lansing 3085'
Drlg. 3146'

5/26 Arbuckle 3334'
TD 3338'
5" @ 3335'
RUST

6/1 500 Acid.
Swb 210 bbls oil & 16 W 14 hrs.

6/9 Pump 126 bbls oil / 20 W in 24 hrs.

6/16 TD 3338'
Arb 3334'
5" @ 3335' 500 acid
Pump 181 Oil / 78 W Pot
40⁹ Gr.
Comp.

COMPLETED

Map No. _____ Sec. 15 Twp. 15 R. 14W

Well No. 3 Mai

Phillips

Company

FIRST REPORT

Contractor

SE SW SW

SECTION PLAT

_____ Ft. from N. Line

330

_____ Ft. from S. Line

_____ Ft. from E. Line

990

_____ Ft. from W. Line

Russell County

Location _____ X _____

Rig up _____

Drilling and Remarks:

RECORD

Cased _____ in., _____ ft.

Sand _____

Gas _____

Oil _____

Total Depth _____

PRODUCTION

1st 24 hrs. Nat. _____

1st 24 hrs. after shot _____

Gas _____ Cu. Ft.

Dry Hole _____

Abandoned _____

Date

APR 28 1948

19

S. J. LEWIS

Scout

Map No. 73 Sec. 15 Twp. 15 R. 14W

Well No. 3 Mai

Phillips

Company

COMPLETE

Contractor

SE SW SW

E 11880
SECTION PLAT

 Ft. from N. Line

330 Ft. from S. Line

 Ft. from E. Line

990 Ft. from W. Line

Russell County

Location

Rig up

Drilling and Remarks:

Cr 8334

5" @ 335'

5000 cu ft

Pump 181 oil + 78W

Prod.

40 I/G

RECORD

Cased in., ft.

Sand

Gas

Oil ✓

Total Depth 3338'

PRODUCTION

1st 24 hrs. Nat.

1st 24 hrs. after shot

Gas Cu. Ft.

Dry Hole

Abandoned

Date

JUN 1 6 1948

19

S. J. LEWIS

Scout