

NO-RECORD

DX 78-1


O.W.W.O.

Woodson KANS 'S

Section 12 Township 24 Range 13E

Well No. 1 Dye

Company T. A. McClasky

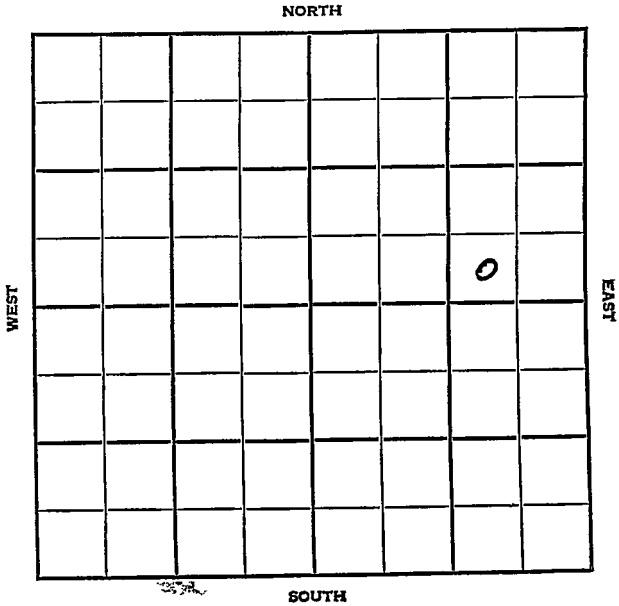

O.W.W.O.

Woodson KANSAS

O-RECORD


WELL NO 12 2 1/2 13 E

COMPANY # 1 Dye FARM

CONTRACTOR T. A. McClasky

Blackwell Pool

Ft. from N. Line
330 Ft. from S. Line
990 Ft. from E. Line
Ft. from W. Line

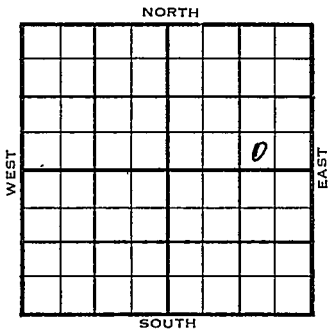

SW SE NE

Table with columns for ELEVATION and REPORT. Row 1: 1954, O.W.W.O. NO-RECORD. Row 2: 8/18, OTD 1750' 00. Row 3: 8/25, Abandoned Location. Row 4: ABANDONED.

Mr. Gilstrap,

Please check the Co. & the twp
& rge. "Which is correct?

Luville

AUG 27 1954

Scout Cards	MM
Land Small Map	
Land Well Map	33
Tracings	
France Map	
Pierce Map	
Misc.	

Orig. Data

