

KANSAS


Russell

FORM 51 5M 1-42 PETROL

Section 15 Township 15 Range 14-W

Well No. #4 Maier

Company Phillips & Continental

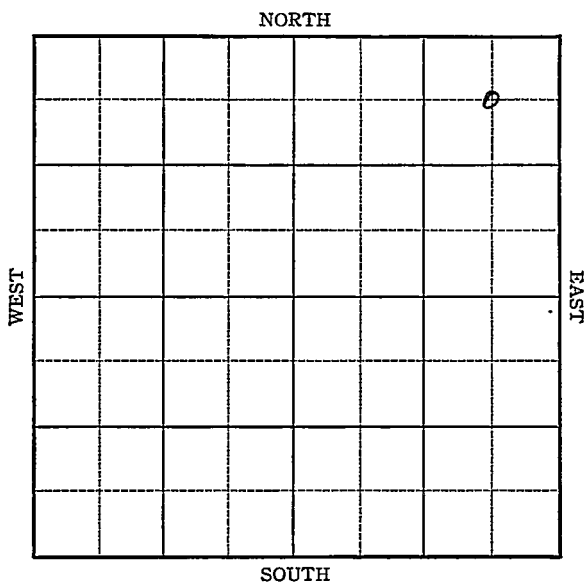

KANSAS

Russell

Sec. 15 Twp. 15 R. 14-W

Well No. #4 Maiër Farm

Phillips & Continental Company


Trapp

660 Ft. from N. Line

 Ft. from S. Line

660 Ft. from E. Line

 Ft. from W. Line

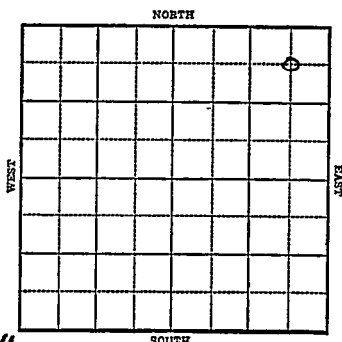

Elev. 1811

1943

R E P O R T

6/30 Drlg. 130'
7/7 8" @ 602'
Drlg. 2586'
7/15 Lans 3022
Arb 3274-76 T.D.
5"D@ 3274
RUST
7/21 T.D. 3288
HFW
SD
7/28 Arb. 3274
5" @ 3274'
T.D. 3288'
500 acid
S.W.D.

ABANDONED

KANSAS**Russell**Map No. 73 Sec. 15 Twp. 15 R. 14WWell No. 4 MaierPhillips & Continental CompanyFIRST REPORT Contractor**C NE NE****SECTION PLAT**660 Ft. from N. Line Ft. from S. Line660 Ft. from E. Line Ft. from W. Line

			o
			.

TRAPP POOLLocation Rig up

Drilling and Remarks:

Drlg. 130'**RECORD**Cased in., ft.Sand Gas Oil Total Depth **PRODUCTION**1st 24 hrs. Nat. 1st 24 hrs. after shot Gas Cu. Ft.Dry Hole Abandoned

Date

JUN 3 0 1943 19 S. J. LEWIS Scout

Rus sell

KANSAS 3
 Map No. 73 Sec. 15 Twp. 15 R. 14W

Well No. 4 Maier

Phillips & Continental Company

~~ABANDONED~~

Contractor

C NE NE **ABANDONED**

SECTION PLAT

660 Ft. from N. Line

Ft. from S. Line

660 Ft. from E. Line

Ft. from W. Line

			o

TRAPP POOL

Location

Rig up

Drilling and Remarks:

Ar 8 3274
5 03274
500 acid
B.W. J

RECORD

Cased in. ft.

Sand

Gas

Oil

Total Depth 3288

PRODUCTION

1st 24 hrs. Nat.

1st 24 hrs. after shot

Gas Cu. Ft.

Dry Hole

Abandoned

Date

JUL 28 1943 19

S. J. LEWIS Scout