

KANSAS

Butler

Section 26 Township 29 Range 5E

Well No. 2 Borett

Company E. Adair

Misc.
NORTH

WEST

EAST

SOUTH

Sec. 26 Twp. 29 R. 5E ✓

Well No. 2 Borett Farm

E. Adair Company

Misc.


 Ft. from N. Line

330 Ft. from S. Line

 Ft. from E. Line

330 Ft. from W. Line

SW NW

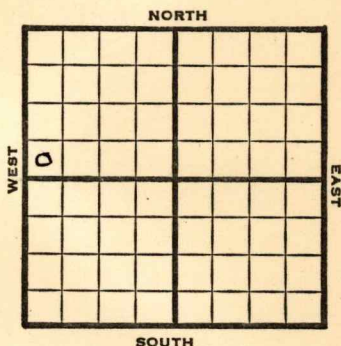

1948

Eli 1348'

REPORT

9/1 Machine

9/8 Drlg. 345'

9/14 15" @ 358'
13" @ 1000'
Drlg. 1095'

9/21 Drlg. 1600'

9/29 10" @ 1815'
8" @ 1995'
Drlg. 2195'

10/6 **Lansing 1810'**
KC 2200'
BKC 2425'
Drlg. 2825'

10/13 "

10/20 TD 2872'
Mississippi 2870'
Aband.

ABANDONED

Butler County Kansas State

Map No. _____ Sec. 26 Twp. 29 R. 5E

Well No. 2 Borett

E. Adair Company

FIRST REPORT

SW NW Contractor


SECTION PLAT

_____ Ft. from N. Line

330 Ft. from S. Line

_____ Ft. from E. Line


330 Ft. from W. Line

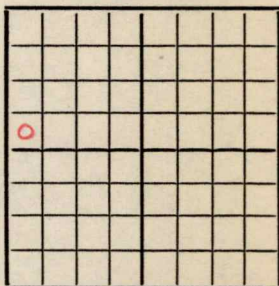

Miscellaneous

Remarks:

Machine

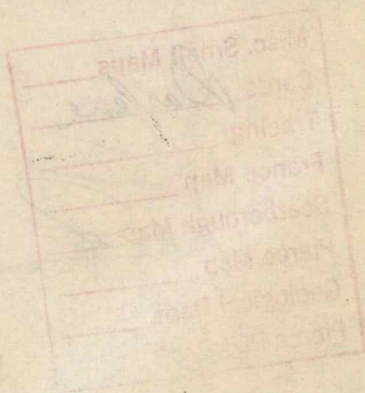

Date
SEP 1 1948

Scout S. J. LEWIS


Map No. 11 Sec. 26 Twp. 29 R. 5EWell No. 2 BorettE. Adair Company

ABANDONED

Contractor

SW NW

SECTION PLAT

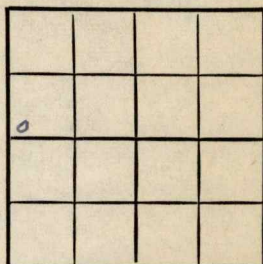 Ft. from N. Line330 Ft. from S. Line Ft. from E. Line330 Ft. from W. Line

Butler County

RECORD

Location Cased in., ft.Rig up Sand

Drilling and Remarks:

Gas Oil Total Depth 2872

PRODUCTION

1st 24 hrs. Nat. 1st 24 hrs. after shot Gas Cu. Ft.Dry Hole Abandoned

Date

OCT 20 1948 19

S. J. LEWIS

Scout