



Woodson

KANSAS

Map No. \_\_\_\_\_ Sec. 11 Twp. 24 R. 13

Well No. 1 Smith Farm


Burt Young et al Company

\_\_\_\_\_ Ft. from N. Line

250 Ft. from S. Line

\_\_\_\_\_ Ft. from E. Line

250 Ft. from W. Line

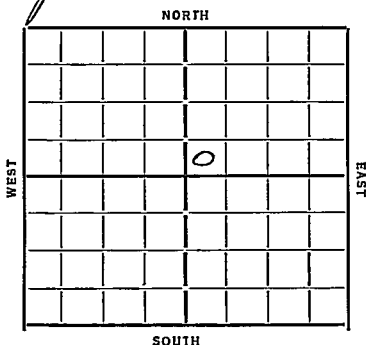

Date 1933

REPORT

5/10 Wdly 576'

5/17 S. 10, 800'

5/24 Dy 1450

6/1 \_\_\_\_\_

6/7 T. D. 1599 H. F. W

**ABANDONED**

*Woodson*

17 **KANSAS** Sec. 11 Twp. 24 R. 13 <sup>E</sup>

Well No. 1 *Smith*

*Burt Young & Co* Company

Contractor

**FIRST REPORTS**

.....Ft. from N. Line

*250* Ft. from S. Line

.....Ft. from E. Line

*250* Ft. from W. Line

**SECTION PLAT**

		0	

Location.....

Rig up.....

Drilling and Remarks:

*ply 570*

**RECORD**

Cased.....in., .....ft.

Sand.....

Gas.....

Oil.....

Total Depth.....

**PRODUCTION**

1st 24 hrs. Nat.....

1st 24 hrs. after shot.....

Gas.....Cu. Ft.

Dry Hole.....

Abandoned.....

Date.....

MAY 10 1933

**CHAS. L. SHERWOOD**

Scout

*Woodson*

Map No. \_\_\_\_\_ Sec. *11* Twp. *24* R. *13 E*

Well No. *1* *Smith*

*Burt Young et al* Company

Contractor

SECTION PLAT

\_\_\_\_\_ Ft. from N. Line

*250* Ft. from S. Line

\_\_\_\_\_ Ft. from E. Line

*250* Ft. from W. Line

		o	

Location \_\_\_\_\_

Rig up \_\_\_\_\_

Drilling and Remarks:

*H.F.W 1599*

**RECORDED**  
**INDEXED**

Cased \_\_\_\_\_ in. \_\_\_\_\_ ft.

Sand \_\_\_\_\_

Gas \_\_\_\_\_

Oil \_\_\_\_\_

Total Depth *1599*

**PRODUCTION**

1st 24 hrs. Nat. \_\_\_\_\_

1st 24 hrs. after shot \_\_\_\_\_

Gas \_\_\_\_\_ Cu. Ft.

Dry Hole \_\_\_\_\_

Abandoned \_\_\_\_\_

Date

*6/7/33* 192 *Oswald Mannschreck* Scout