

*Sawley*

Map No. **KANSAS** Sec. *1* Twp. *33* S R. *4E*

Well No. *1 - Bills* Farm  
*Wichita Nat* Company

NORTH

WEST

EAST


SOUTH

Location.....

Rig Up.....

Drilling Remarks

Drilling Remarks

.....

.....

RECORD

PRODUCTION

Cased..... in..... ft.

1st 24 hrs. Nat.....

Sand.....

1st 24 hrs. after shot.....

Gas.....

Gas..... cu. ft.....

Oil.....

Dry Hole.....

Total Depth.....

Abandoned.....

Map No. .... Sec. .... Twp. .... R. ....

Well No. .... Farm


..... Company

..... Ft. from N. Line

..... Ft. from S. Line

..... Ft. from E. Line

..... Ft. from W. Line

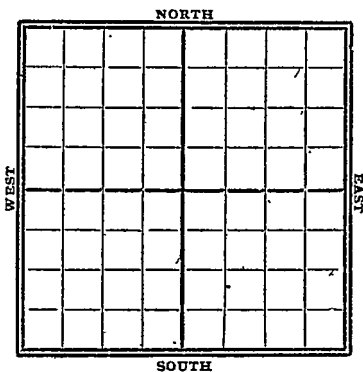

1917

Date

REPORT

*Gypsy Records*

1/16

*Abd T.O. 1630'*

*Cowley*  
MAP NO. K2 KANSAS SEC. 1 TWP. 33S R. 1E

WELL NO. 1 *Bill*  
Wichita National COMPANY

CONTRACTOR

SECTION PLAT

ABANDONED

●			

\_\_\_\_\_ FT. FROM N. LINE  
\_\_\_\_\_ FT. FROM S. LINE  
\_\_\_\_\_ FT. FROM E. LINE  
\_\_\_\_\_ FT. FROM W. LINE

*Bill*

LOCATION \_\_\_\_\_  
RIG UP \_\_\_\_\_  
DRILLING AND REMARKS:

RECORD

CASED \_\_\_\_\_ IN., \_\_\_\_\_ FT.  
SAND \_\_\_\_\_  
GAS \_\_\_\_\_  
OIL \_\_\_\_\_  
TOTAL DEPTH 1630

PRODUCTION

1ST 24 HRS. NAT. \_\_\_\_\_  
1ST 24 HRS. AFTER SHOT \_\_\_\_\_  
GAS \_\_\_\_\_ CU. FT.  
DRY HOLE ✓  
ABANDONED ✓

DATE 1-16 1917

SCOUT