



Map No. .... Sec. .... Twp. .... R. ....

Well No. .... Farm


..... Company

..... Ft. from N. Line

..... Ft. from S. Line

..... Ft. from E. Line

..... Ft. from W. Line

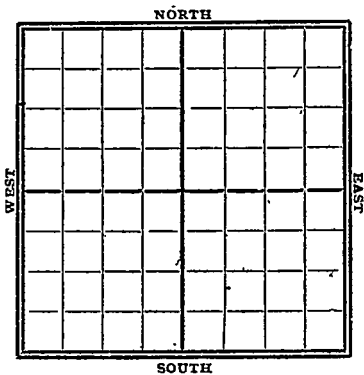

1924

Date

REPORT

*Gypsy Records*  
*Abd T.D. 1500'*

K2 Crowley  
MAP NO. KANSAS SEC. 26 TWP. 32S 4E R. 1E

WELL NO. 2704  
Rocknider opal COMPANY

CONTRACTOR

SECTION PLAT

ABANDONED

\_\_\_\_\_ FT. FROM N. LINE  
\_\_\_\_\_ FT. FROM S. LINE  
\_\_\_\_\_ FT. FROM E. LINE  
\_\_\_\_\_ FT. FROM W. LINE


RECORD

LOCATION \_\_\_\_\_  
RIG UP \_\_\_\_\_  
DRILLING AND REMARKS:

CASED \_\_\_\_\_ IN., \_\_\_\_\_ FT.  
SAND \_\_\_\_\_  
GAS \_\_\_\_\_  
OIL \_\_\_\_\_  
TOTAL DEPTH 1500



PRODUCTION

1ST 24 HRS. NAT. \_\_\_\_\_  
1ST 24 HRS. AFTER SHOT \_\_\_\_\_  
GAS \_\_\_\_\_ Cu. Ft.  
DRY HOLE u  
ABANDONED \_\_\_\_\_

DATE 2/18 1924

SCOUT