

Well No. 16-1000 Farm

Veckita Nak Company

WEST

EAST

SOUTH

Location_____

Drilling Remarks

[illegible]

RECORD

Cased.....in.....ft.

Sand_____

Gas.....

Oil_____

Total Depth.....

Rig Up.....

Drilling Remarks

[illegible]

PRODUCTION

1st 24 hrs. Nat.....

1st 24 hrs. after shot.....

Gas.....cu. ft.....

Dry Hole.. ..

Abandoned.....

Map No.....Sec.....Twp.....R.....

Well No.....Farm


.....Company

.....Ft. from N. Line

.....Ft. from S. Line

.....Ft. from E. Line

.....Ft. from W. Line

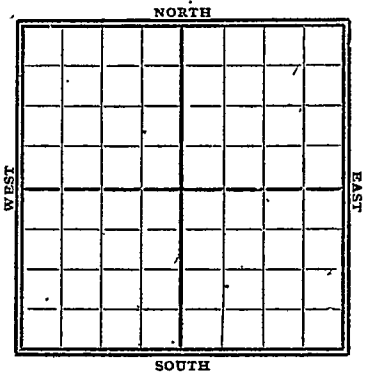

1917

Date

REPORT

Gypsy Records
Abd T.D. 1500'

K2 KANSAS SEC. 36 TWP. 32S 4E
MAP No. _____

WELL No. 1 Kerchley
Archita Act COMPANY

CONTRACTOR

SECTION PLAT

ABANDONED

_____ FT. FROM N. LINE

_____ FT. FROM S. LINE

_____ FT. FROM E. LINE

_____ FT. FROM W. LINE

LOCATION _____

RIG UP _____

DRILLING AND REMARKS:

RECORD

CASED _____ IN. _____ FT.

SAND _____

GAS _____

OIL _____

TOTAL DEPTH 1500

PRODUCTION

1ST 24 HRS. NAT. _____

1ST 24 HRS. AFTER SHOT _____

GAS _____ CU. FT.

DRY HOLE ☒

ABANDONED ☒

DATE

4-11-17 SCOUT