

Map No. Sec. 25 Twp. 29 R. 5

Well No. 8 Warner Farm


Elmer Oil Company

1070 Ft. from N. Line

 Ft. from S. Line

250 Ft. from E. Line

 Ft. from W. Line

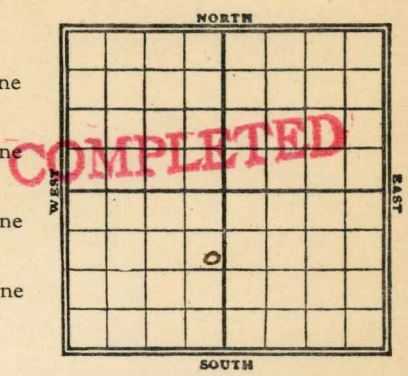

Date

REPORT

5/4 Dily 320 **FIRST REPORT**

6/8 Gap sand 27.3'

6/14 27.3-81 30/60

Map No. K 11 Sec. 25 Twp. 29 R. 5

Well No. 8 Harner

Elma Oil Company

Contractor

SECTION PLAT

1070 Ft. from N. Line

_____ Ft. from S. Line

250 Ft. from E. Line

_____ Ft. from W. Line

COMPLETED

Location _____

Rig up _____

Drilling and Remarks:

Shot 30 qts

RECORD

Cased _____ in., _____ ft.

Sand 2713 - 81

Gas _____

Oil _____

Total Depth _____

PRODUCTION

1st 24 hrs. Nat. _____

1st 24 hrs. after shot 60 bbls

Gas _____ Cu. Ft.

Dry Hole _____

Abandoned _____

Date

6/14 1920

Pyle

Scout