

KANSAS

Butler

Sec. 25 Twp. 29 R. 5E

Well No. #18 Warner Farm

C R A

Company

Miscellaneous

Ft. from N. Line

660'


Ft. from S. Line

Ft. from E. Line

330'

Ft. from W. Line

C W L SW NE

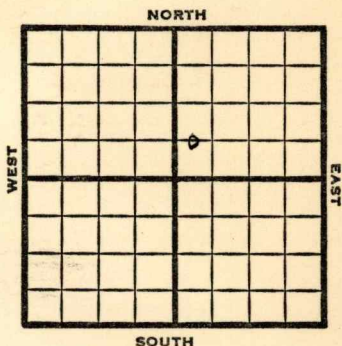

1949

^Elev 1318'

REPORT

3/23

Location

3/30

8" @ 92'

Drlg. 147'

4/6

KC 2122'

D_rlg. 2468'

4/12

Bart 2761'

TD 2778'

7" @ 2763'

4/20

TD 2799'

4/27

40 qts 2767

2781 CO

5/4

"

5/11

TD 2799'

Bart 2761'

7" @ 2763'

40 qts.

Aband.

ABANDONED

Map No. _____ Sec. 25 Twp. 29 R. 5E

Well No. 18 Warner

C R A _____ Company

FIRST REPORT _____ Contractor

C W L SW NE

SECTION PLAT

_____ Ft. from N. Line

660 Ft. from S. Line

_____ Ft. from E. Line

330 Ft. from W. Line

		0	

Butler County

Location X

Rig up _____

Drilling and Remarks:

RECORD

Cased _____ in., _____ ft.

Sand _____

Gas _____

Oil _____

Total Depth _____

PRODUCTION

1st 24 hrs. Nat. _____

1st 24 hrs. after shot _____

Gas _____ Cu. Ft.

Dry Hole _____

Abandoned _____

Date

MAR 23 1949 19

S. J. LEWIS

Scout

Map No. K 11 Sec. 25 Twp. 29 R. 5E

Well No. 18 Warner

C R A Company

ABANDONEE Contractor

C W L SW NE

E. 1318
SECTION PLAT

 Ft. from N. Line

660 Ft. from S. Line

 Ft. from E. Line

330 Ft. from W. Line

		0	

Butler County

Location

Rig up

Drilling and Remarks:

Bart 2761
7" @ 2763
40 ft

RECORD

Cased in., ft.

Sand

Gas

Oil

Total Depth 2758

PRODUCTION

1st 24 hrs. Nat.

1st 24 hrs. after shot

Gas Cu. Ft.

Dry Hole

Abandoned

Date

MAY 11 1949 19

S. J. LEWIS Scout