


Map No. Kans 14 Sec. 14 Twp. 25 R. 13

Well No. 1 Mason Farm
McLean + Johnson Company

NORTH

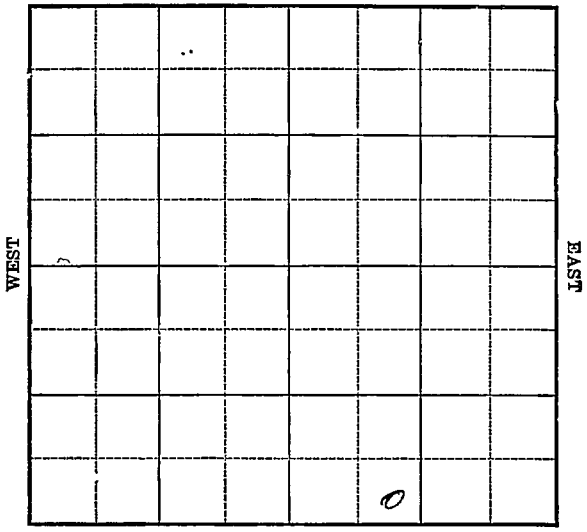

SOUTH

Location _____
Drilling Remarks _____

Rig Up _____
Drilling Remarks _____

RECORD

Cased _____ in. _____ ft.

Sand _____

Gas _____

Oil _____

Total Depth _____

PRODUCTION

1st 24 hrs. Nat. _____

1st. 24 hrs. after shot _____

Gas _____ cu. ft.

Dry Hole _____

Abandoned _____

Map No. Kan Sec. 14 Twp. 25 R. 13th


Well No. 1 Mason Farm
M^o Cannon & Johnson Company

_____ Ft. from N. Line

250' Ft. from S. Line

_____ Ft. from E. Line

1120' Ft. from W. Line

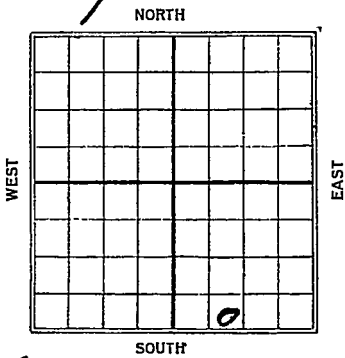

Machine

1925	REPORT
7/24	Speed
7/31	700'
8/7	1090'
8/14	—
8/20	1200'
8/27	—
9/3	SD, 1200'
9/11	—
9/16	—
9/24	—
10/1	—
10/8	Machine
10/16	—
10/22	—
10/29	—
11/27	D. & A. 1535'

Map No. Sub Sec. 14 Twp. 25 R. 13

Well No. 1 Mason

Mc Carr & Johnson Company

Contractor

FIRST REPORTS

SECTION PLAT

_____ Ft. from N. Line

250 Ft. from S. Line

_____ Ft. from E. Line

1120 Ft. from W. Line

		o	

Location _____

Rig up _____

Drilling and Remarks:

"machine"
Spudding

RECORD

Cased _____ in., _____ ft.

Sand _____

Gas _____

Oil _____

Total Depth _____

PRODUCTION

1st 24 hrs. Nat. _____

1st 24 hrs. after shot _____

Gas _____ Cu. Ft.

Dry Hole _____

Abandoned _____

Date

JUL 24 1925

192

CHAS. L. SHERWOOD

Scout

Woodson Co

Map No. *W. Map* **KANSAS** Sec. *14* Twp. *25* R. *13*

Well No. *1* *Madson*

The Cann & Johnson Company

Contractor

COMPLETED

SECTION PLAT

_____ Ft. from N. Line

250

_____ Ft. from S. Line

_____ Ft. from E. Line

1120

_____ Ft. from W. Line

G

ABANDONED

Location _____

Rig up _____

Drilling and Remarks:

Dry & wht

20 1535

RECORD

Cased _____ in., _____ ft.

Sand _____

Gas _____

Oil _____

Total Depth *1535*

PRODUCTION

1st 24 hrs. Nat. _____

1st 24 hrs. after shot _____

Gas _____ Cu. Ft.

Dry Hole

Abandoned

Date

NOV 27 1925

CHAS. L. SHERWOOD

192

Scout