

KANSAS


Russell

FORM 51 5M 4-41 PETROL

Section 15 Township 15 Range 14W

Well No. #2 Maier

Company Phillips Petroleum

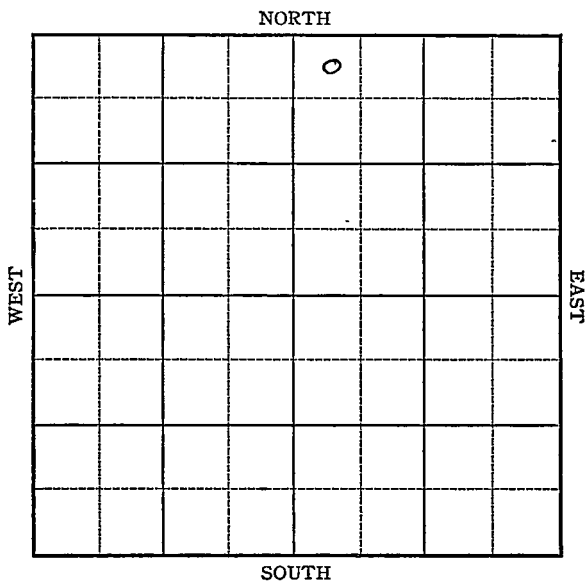

Map No. _____ Sec. 15 Twp. 15 R. 14WWell No. 2 MaierPhillips Petroleum

Company

~~FIRST REPORT~~

Contractor

SECTION PLAT

NW NE

467 Ft. from N. Line

_____ Ft. from S. Line

_____ Ft. from E. Line

467 Ft. from W. Line

		o	

TRAPP POOL

RECORD

Location _____

Cased _____ in., _____ ft.

Rig up _____

Sand _____

Drilling and Remarks:

Gas _____

8" - 586

Oil _____

Drlg 2845

Total Depth _____

PRODUCTION

1st 24 hrs. Nat. _____

1st 24 hrs. after shot _____

Gas _____ Cu. Ft.

Dry Hole _____

Abandoned _____

Date

JUN 25 194119S. J. LEWIS

Scout

Map No. _____ Sec. 15 Twp. 15 R. 14WWell No. 2 Maier

Phillips Petroleum Company

COMPLETED Contractor

NW NE

SECTION PLAT

		0	

467 Ft. from N. Line

_____ Ft. from S. Line

_____ Ft. from E. Line

467 Ft. from W. Line

TRAPP POOL

Location _____

Rig up _____

Drilling and Remarks:

*Cor 3217**5" @ 3217**1000 acid**Pump 30 oil to water**39 2/3*

RECORD

Cased _____ in., _____ ft.

Sand _____

Gas _____

Oil _____

Total Depth 3224

PRODUCTION

1st 24 hrs. Nat. _____

1st 24 hrs. after shot _____

Gas _____ Cu. Ft.

Dry Hole _____

Abandoned _____

Date

JUL 30 1941

19

S. J. LEWIS

Scout