

KANSAS

Russell

FORM 51 5M 4-41 PETROL

Section 15 Township 15 Range 14-WWell No. #2 paulineCompany Phillips & Continental

NORTH

			0				


SOUTH

WEST

EAST

Sec. 15 Twp. 15 R. 14-WWell No. #2 Pauline FarmPhillips & Continental Company
(Trapp)46 7 Ft. from N. Line Ft. from S. Line46 7 Ft. from E. Line Ft. from W. Line

Elev. 1758

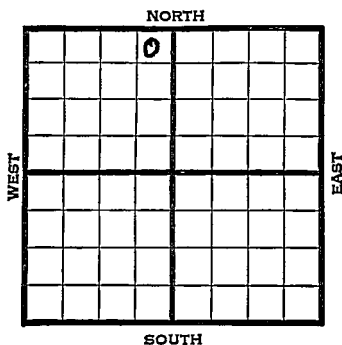

1941

REPORT

7/1 Location

7/10 8" - 59 7' Anhy 760'

Drlg. 1822'

7/17 Lans. 2960' Drlg. 3145'

7/24 Arb 3219-29 TD 5" @ 3219 RYST

7/31 " " "

8/7 TD 3229' 500 acid.

8/13 Lans. 2960'

Arb. 3219'

5" - 3219'

500 acid

T.D. 3229'

Pmp. Pot. 82 oil & 3% water

Grav. 39

COMPLETED

Map No. 73 Sec. 15 Twp. 15 R. 14WWell No. 2 PaulinePhillips & Continental CompanyFIRST REPORT Contractor

NE NW

SECTION PLAT

467 Ft. from N. Line

Ft. from S. Line

467 Ft. from E. Line

Ft. from W. Line

TRAP P POOL

	6		

Location X

Rig up

Drilling and Remarks:

RECORD

Cased _____ in., _____ ft.

Sand _____

Gas _____

Oil _____

Total Depth _____

PRODUCTION

1st 24 hrs. Nat. _____

1st 24 hrs. after shot _____

Gas _____ Cu. Ft.

Dry Hole _____

Abandoned _____

Date

JUL 1 1941 19S. J. LEWIS Scout

KANSAS

Form 26 200 Bks. 5-41 McW. Russell

Map No. 73 Sec. 15 Twp. 15 R. 14WWell No. 2 PaulinePhillips & Continental Company

Contractor

NE NW

SECTION PLAT

	0		

467 Ft. from N. Line

Ft. from S. Line

467 Ft. from E. Line

Ft. from W. Line

TRAPP POOL

Location

Rig up

Drilling and Remarks:

Land 2960
 arb. 3219
 5" 3219
 500 acid

Pump Pot 82 oil + 3% water

COMPLETED

RECORD

Cased _____ in., _____ ft.

Sand _____

Gas _____

Oil _____

Total Depth 3229

PRODUCTION

1st 24 hrs. Nat. _____

1st 24 hrs. after shot _____

Gas _____ Cu. Ft.

Dry Hole _____

Abandoned _____

Date

AUG 13 1941

19

S. J. LEWIS

Scout