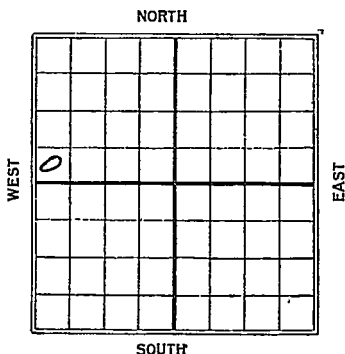


Map No. Kansas Sec. 24 Twp. 25 R. 13 ^{NE}Well No. 1 mill FarmLassen et al Company

_____ Ft. from N. Line

250 Ft. from S. Line

_____ Ft. from E. Line

250 Ft. from W. Line

Date

REPORT

19254/10Sky 4505/8Abandoned 1451

Map No. *KL 46* Sec. *24* Twp. *25* R. *13^E*
 Well No. *1* *mills*
LASSEN *OT HL* Company

Contractor

FIRST REPORTS

SECTION PLAT

0			

Ft. from N. Line

250 Ft. from S. Line

Ft. from E. Line

250 Ft. from W. Line

Location

Rig up

Drilling and Remarks:

Depth 450'

RECORD

Cased _____ in., _____ ft.

Sand _____

Gas _____

Oil _____

Total Depth _____

PRODUCTION

1st 24 hrs. Nat. _____

1st 24 hrs. after shot _____

Gas _____ Cu. Ft.

Dry Hole _____

Abandoned _____

Date

APR 10 1925

192

Chas. L. Sheward
Scout

Map No. 1444 Sec. 24 Twp. 25 R. 13Well No. 1 MillsLassen & Co Company

Contractor

ABANDONED

SECTION PLAT

Ft. from N. Line

250 Ft. from S. Line

Ft. from E. Line

250 Ft. from W. Line

COMPLETED

0			

Location

Rig up

Drilling and Remarks:

#311 1075-1105'Day 2 1451'no find.

RECORD

Cased _____ in., _____ ft.

Sand _____

Gas _____

Oil _____

Total Depth 1451'

PRODUCTION

1st 24 hrs. Nat. _____

1st 24 hrs. after shot _____

Gas _____ Cu. Ft.

Dry Hole ☒Abandoned ☒

Date

MAY 8 1925

192

CHAS. L. SHERWOOD

Scout