KANSAS

FORM 51 5M PETROL


Russell

Section 16 Township 15 Range 14W

Well No. #1 Martha Strecker

Company Auto Ord. Etal.

Trapp Pool

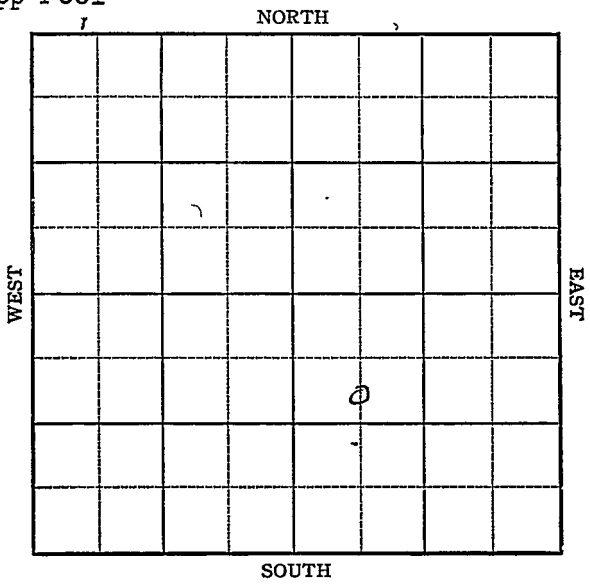

FORM A-32 KANSAS
5M 9-43 GASS

Russell

Sec. 16 Twp. 15 R. 14-W

Well No. #1 Martha Strecker Farm


Auto Ordnance etal Company

990 Ft. from N. Line

_____ Ft. from S. Line

_____ Ft. from E. Line

660 Ft. from W. Line

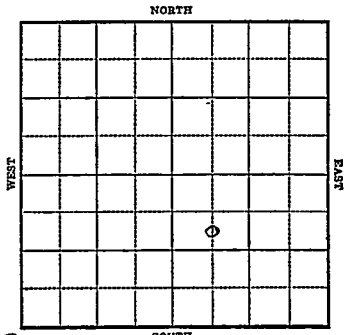

Elev. 1789

1943	REPORT
12-22	Rotary
12/29	"
1944	
1-5	Surface Hole
1-12	"
1/19	"
1/26	8" @ 575 Drlg. 2540'
2/2	Topeka 2718 Lans 3002 SO 3029-32, 3188-92 Cong 3253 Arb 3260 TD 3311 No shows.
2/9	Topeka 3718 Lans 3002 Arb 3260 TD 3311 No shows

ABANDONED

Form 26 200 Bks 5-42 Petrol

Russell

KANSAS

Map No. 73 Sec. 16 Twp. 15 R. 14W

Well No. 1 Martha Strecker

Auto Ordnance etal. Company

FIRST REPORT Contractor

C S L NW SE


990 Ft. from N. Line

_____ Ft. from S. Line

_____ Ft. from E. Line

660 Ft. from W. Line

SECTION PLAT

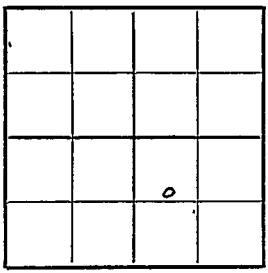

Trapp Pool

Location

Rig up

Drilling and Remarks:

Rotary

RECORD

Cased _____ in., _____ ft.

Sand

Gas

Oil

Total Depth

PRODUCTION

1st 24 hrs. Nat.

1st 24 hrs. after shot

Gas _____ Cu. Ft.

Dry Hole

Abandoned

Date

DEC 2 2 1943 19

S. J. LEWIS Scout

Form 26 200 Bks 5-42 Petrol Russell

Map No. KANSAS Sec. 16 Twp. 15 R. 14W

Well No. 1 Martha Strecker

Auto Ordnance etal. Company

ABANDONED Contractor

C S L NW SE


990 Ft. from N. Line

____ Ft. from S. Line

____ Ft. from E. Line

660 Ft. from W. Line

SECTION PLAT

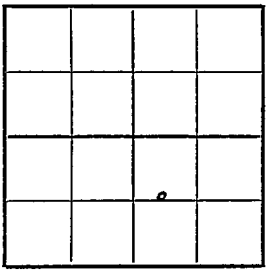

Trapp Pool

Location

Rig up

Drilling and Remarks:

Top Ka 2718

Lans 3002

TD 3260

Abandoned

RECORD

Cased ____ in., ____ ft.

Sand

Gas

Oil

Total Depth 3311

PRODUCTION

1st 24 hrs. Nat.

1st 24 hrs. after shot

Gas ____ Cu. Ft.

Dry Hole

Abandoned

Date

FEB 9 1944 19

S. J. LEWIS Scout