


Section 27 Township 29 Range 5-E

Well Number 1 - Connell

Company Sacco et al

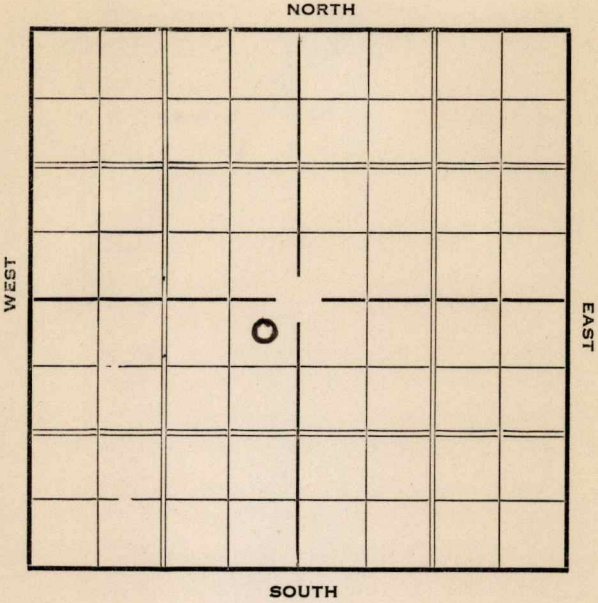

Sec. 27 Twp. 29 R. 5-E

Well No. #1 Connell Farm

Sacco et al Company


330 Ft. from N. Line

_____ Ft. from S. Line

330 Ft. from E. Line

_____ Ft. from W. Line

Elev. 1325

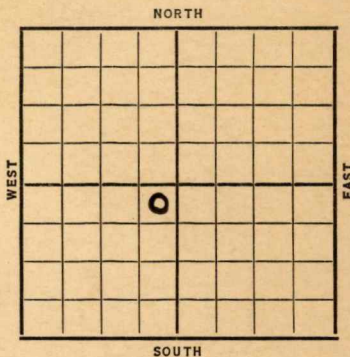

Date	REPORT
1937	
5/5	Mov. in Mach.
5/14	" " "
5/21	R. U. Machine.
5/28	" " "
6/4	" " "
6/11	" " "
6/19	15" @ 575'. Drlg. 875'.
6/25	Drlg. 1325'.
7/2	10" @ 1728'. Drlg. 1950'.
7/9	Drlg. 2215'.
7/16	" "
7/21	KC 2206'
	Miss 2850'
	TD 2856'
	D&A
	ABANDONED

Map No. 11 Sec. 27 Twp. 29 R. 5^E

Well No. 1 - Connell

Sacco etal Company

Contractor

FIRST REPORT

SECTION PLAT

	0		

330 Ft. from N. Line

_____ Ft. from S. Line

330 Ft. from E. Line

_____ Ft. from W. Line

Location _____

Rig up _____

Drilling and Remarks:

mov. in mach.

RECORD

Cased _____ in., _____ ft.

Sand _____

Gas _____

Oil _____

Total Depth _____

PRODUCTION

1st 24 hrs. Nat. _____

1st 24 hrs. after shot _____

Gas _____ Cu. Ft.

Dry Hole _____

Abandoned _____

Date

MAY 5 - 1937 19

H. D. Hatfield Scout

Butler

Map No. 11 Sec. 27 Twp. 29 R. 5-E

Well No. 1-Connell

Sacco & Maurer Company

Contractor

ABANDONED

SECTION PLAT

330 Ft. from N. Line
 _____ Ft. from S. Line
330 Ft. from E. Line
 _____ Ft. from W. Line

	0		

Location _____

Rig up _____

Drilling and Remarks:

DVA

RECORD

Cased _____ in., _____ ft.

Sand KC 2206

Gas MISS 2850

Oil _____

Total Depth 2856

PRODUCTION

1st 24 hrs. Nat. _____

1st 24 hrs. after shot _____

Gas _____ Cu. Ft.

Dry Hole _____

Abandoned _____

Date

JUL 21 1937

H. D. Hatfield

19

Scout