

Woodson

Form 252-A
5M 4-32 MPC

Map No. KANSAS Sec. 9 Twp. 25 R. 14E

Well No. 1-Munson Farm


Floyd Fields Company

1070 Ft. from N. Line

_____ Ft. from S. Line

1070 Ft. from E. Line

_____ Ft. from W. Line

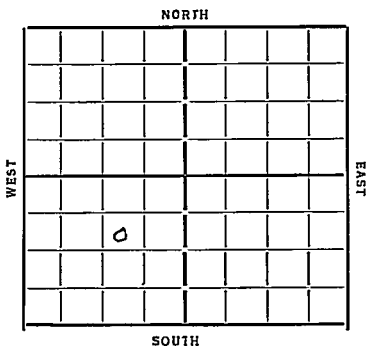

Date

REPORT

1933

6/14

S. D. 500'

6/21

—

6/28

—

7/5

—

7/12

—

7/19

—

7/26

—

8/2

—

8/9

C.D.

8/17

—

8/22

T.D. 1501' NO+G

ABANDONED

Woodson
 Map No. Sec. 9 Twp. 25 R. 14 E

Well No. 1 - Munson
Lloyd Fields Company

Contractor

SW NE SW SECTION PLAT


1070 Ft. from N. Line

..... Ft. from S. Line

1070 Ft. from E. Line

..... Ft. from W. Line

FIRST REPORTS

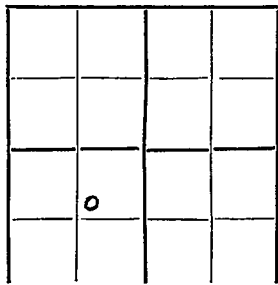

Location

Rig up

Drilling and Remarks:

SD 500'

RECORD

Cased.....in.,ft.

Sand.....

Gas.....

Oil.....

Total Depth.....

PRODUCTION

1st 24 hrs. Nat.....

1st 24 hrs. after shot.....

Gas.....Cu. Ft.

Dry Hole.....

Abandoned.....

Date

6/14/33 192 Oval Manschreck

Map No. 17 Sec. 9 Twp. 25 R. 14E

Well No. 1 - Munson
Floyd Fields, Company

Contractor

ABANDONED

1070 Ft. from N. Line

..... Ft. from S. Line

1070 Ft. from E. Line

..... Ft. from W. Line

SECTION PLAT

	0		

Location.....

Rig up.....

Drilling and Remarks:

W.A.A.

RECORD

Cased..... in., ft.

Sand.....

Gas.....

Oil.....

Total Depth 1501

PRODUCTION

1st 24 hrs. Nat.....

1st 24 hrs. after shot.....

Gas..... Cu. Ft.

Dry Hole.....

Abandoned.....

Date

8/23/33 O. Manschreck
 192 Scout