

Map No. Kansas Sec. 24 Twp. 25 R. 13^E

Well No. 1 Eadie Farm


Lassen & Davis Company

200 Ft. from N. Line

_____ Ft. from S. Line

_____ Ft. from E. Line

200 Ft. from W. Line

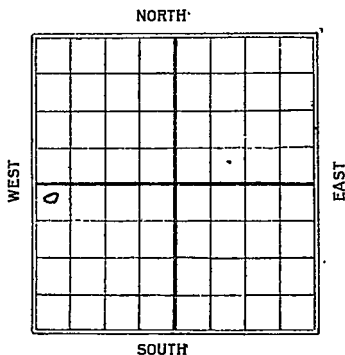

C.

Date

1925

REPORT

4/6 Machine

1925

9/5 D. & A. 1451

Map No. **ANSAB** Sec. **24** Twp. **25** R. **13**Well No. **1** *Cades**Lassen & Davis* Company

Contractor

FIRST REPORT

SECTION PLAT

200' Ft. from N. Line

_____ Ft. from S. Line

_____ Ft. from E. Line

200 Ft. from W. Line

0			

Location _____

Rig up _____

Drilling and Remarks:

Machine

RECORD

Cased _____ in., _____ ft.

Sand _____

Gas _____

Oil _____

Total Depth _____

PRODUCTION

1st 24 hrs. Nat. _____

1st 24 hrs. after shot _____

Gas _____ Cu. Ft.

Dry Hole _____

Abandoned _____

Date

APR 6 1925

192

M. A. BENEAR

Scout

No Map
 Map No. KANSAS Sec. 24 Twp. 25 R. 12

Well No. 1 Cades

Adrian L. Davis Company

Contractor

COMPLETED

SECTION PLAT

200 Ft. from N. Line

----- Ft. from S. Line

----- Ft. from E. Line

200 Ft. from W. Line

0			

ABANDONED

Location -----

Rig up -----

Drilling and Remarks:

Dry & khd
L. D. 1451'

RECORD

Cased ----- in., ----- ft.

Sand -----

Gas -----

Oil -----

Total Depth 1451

PRODUCTION

1st 24 hrs. Nat. -----

1st 24 hrs. after shot -----

Gas ----- Cu. Ft.

Dry Hole ☒

Abandoned ☒

Date

SEP 5 1925

----- 192

CHAS. L. SHERWOOD

Scout