

KANSAS


FORM 51 5M 1-42 PETROL

Russe111

Section 21 Township 15 Range 14-W

Well No. #1 David Bender

Company Ohio etal

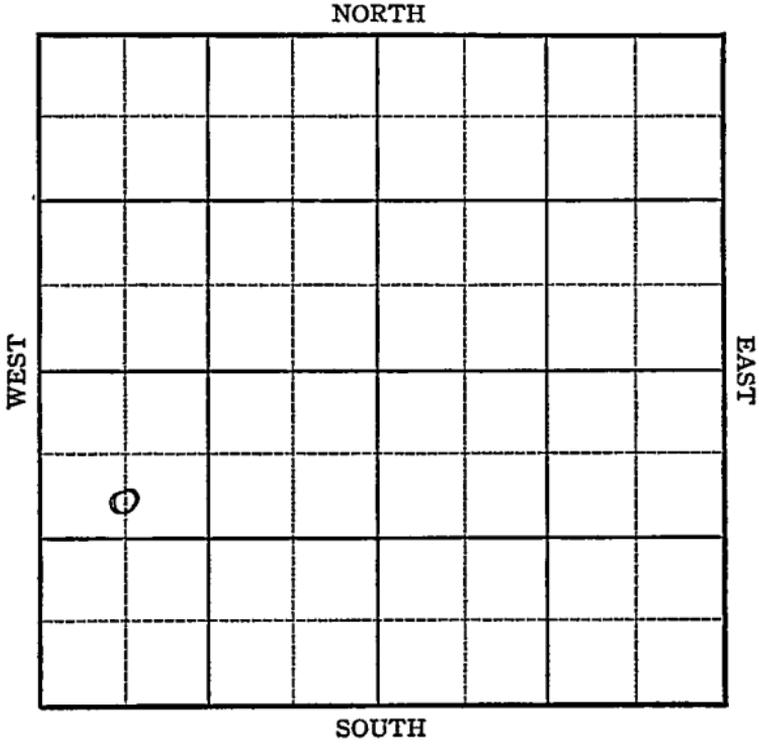

Sec. 21 Twp. 15 R. 14-W

Well No. #1 David Bender Farm

Ohio etal Company


990 Ft. from N. Line

_____ Ft. from S. Line

_____ Ft. from E. Line

660 Ft. from W. Line

Elev. 1816

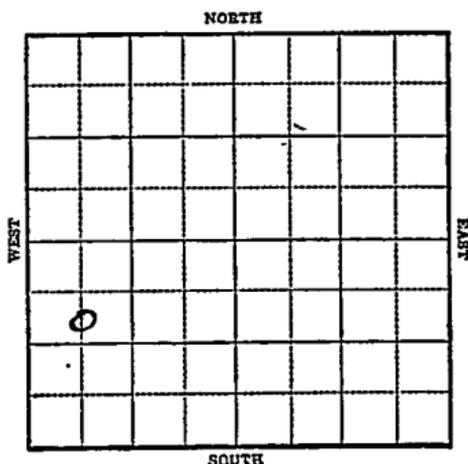

1944

R E P O R T

1-19	Location
1/26	Surface hole
2/2	6" @ 800 Drlg. 1485'
2/8	Drlg. 2570'
2/15	Lans 3031 SO to 3226 BKC 3250 Arb 3289 TD 3293 4" @ 3290 Rust
2/23	"
3/1	500 acid 1000' oil in 6 hrs.
3/8	" " "
3/16	" " "
3/22	" " "
3/29	" " "
4/5	" " "
4/12	" " "
4/19	" " "
4/26	" " "

OVER

1944

5/3

500 acid 1000' oil in 6 hrs.

5/10

" "

5/17

Arbuckle 3289

4" - 3290

500 acid

Pot. - Pump 60

40.4 Gravity

Total Depth 3293

COMPLETED

KANSAS

Map No. 73 Sec. 21 Twp. 15 R. 14W

Well No. 1 David Bender

Ohio etal. Company

FIRST REPORT Contractor

C S L NW SW


SECTION PLAT

990 Ft. from N. Line

_____ Ft. from S. Line

_____ Ft. from E. Line

660 Ft. from W. Line

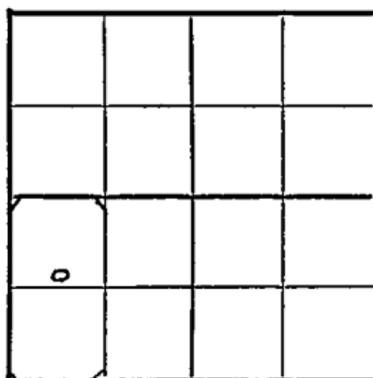

Strecker Pool

Location X

Rig up _____

Drilling and Remarks:

RECORD

Cased _____ in., _____ ft.

Sand _____

Gas _____

Oil _____

Total Depth _____

PRODUCTION

1st 24 hrs. Nat. _____

1st 24 hrs. after shot _____

Gas _____ Cu. Ft.

Dry Hole _____

Abandoned _____

Date

JAN 19 1944 19

S. J. LEWIS Scout

KANSAS

Pool Name Strecker

Map No. 73 Sec. 21 Twp. 15 R. 14W

Well No. 1 David Bender

Ohio etal. Company

COMPLETED

Contractor

C S L NW SW

SECTION PLAT

990 Ft. from N. Line

_____ Ft. from S. Line

_____ Ft. from E. Line

660 Ft. from W. Line

Russell County

RECORD

Location _____

Cased _____ in., _____ ft.

Rig up _____

Sand _____

Drilling and Remarks:

Gas _____

Oil _____

Total Depth 329.3

Cr 43289

4" @ 3290

500cc oil

Pump 60 P.D.

40 # Gr

PRODUCTION

1st 24 hrs. Nat. _____

1st 24 hrs. after shot _____

Gas _____ Cu. Ft.

Dry Hole _____

Abandoned _____

Date

MAY 17 1944

19

S. J. LEWIS

Scout